

Map No. KANSAS Sec. 11 Twp. 20 R. 3

Well No. 21 - Quens Farm

NORTH

WEST

EAST

SOUTH

Location _____
Drilling Remarks _____

Rig Up-----
Drilling Remarks

RECORD

Cased _____ in. _____ ft.

Sand

Gas

Oil

Total Depth_____

PRODUCTION

1st 24 hrs. Nat.-----

1st 24 hrs. after shot_____


Gas_____cu. ft._____

Dry Hole_____

Abandoned

Map No. KANSAS Sec. 11 Twp. 20 R. 5^w
 Well No. 1-1 Quens Farm
W. J. McPherson et al Company

_____ Ft. from N. Line
330 Ft. from S. Line
330 Ft. from E. Line
1930 Ft. from W. Line

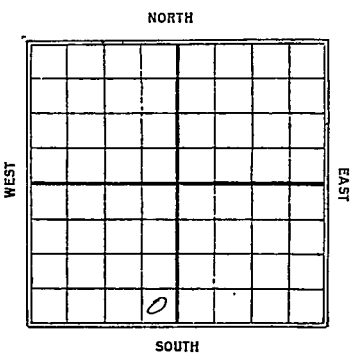

Date	REPORT
9/24	Machine
10/1	1000' 550'
10/8	" 1400'
10/15	517 1400'
10/22	Stand 1020-41
	T.D. 1041' (52M)
	1/5 M Gas
	Q85# R.P.
	Corp.

Map No. KANSAS Sec. 10 Twp. 20 R. 5W

48

Well No. 1 TiersW. E. McPherson & Co. Company

Contractor

SECTION PLAT

_____ Ft. from N. Line

330 Ft. from S. Line330 Ft. from E. Line

_____ Ft. from W. Line

FIRST REPORTS

Location _____

Rig up _____

Drilling and Remarks:

Mackfor gas

RECORD

Cased _____ in., _____ ft.

Sand _____

Gas _____

Oil _____

Total Depth _____

PRODUCTION

1st 24 hrs. Nat. _____

1st 24 hrs. after shot _____

Gas _____ Cu. Ft.

Dry Hole _____

Abandoned _____

Date

SEP 24 1930

S. J. LEWIS

Scout

Map No. KANSAS Sec. 11 Twp. 20 R. 5W

Well No. 1 Kans.

A. E. McPherson & Co. Company

Contractor

SECTION PLAT

.....Ft. from N. Line

330 Ft. from S. Line

330 Ft. from E. Line

.....Ft. from W. Line

COMPLETED

Location.....

Rig up.....

Drilling and Remarks:

85* R. P.

RECORD

Cased.....in.,ft.

Sand 1020-41

Gas 1/5 M

Oil.....

Total Depth 1041.34 M

PRODUCTION

1st 24 hrs. Nat.....

1st 24 hrs. after shot.....

Gas.....Cu. Ft.

Dry Hole.....

Abandoned.....

Date

OCT 22 1930

S. J. LEWIS

Scout