


Map No. KANSAS Sec. 11 Twp. 20 R. 5 W.
 Well No. 1-2 Farm 9
Mid-Kansas Oil Company

NORTH

WEST

EAST

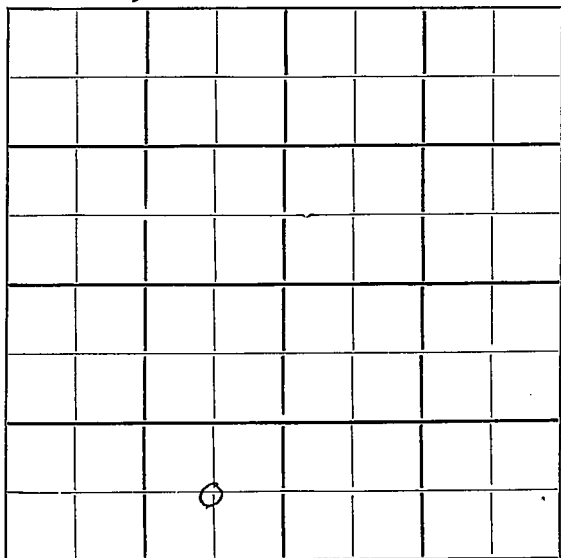

SOUTH

Location.....

Drilling Remarks

.....

.....

RECORD

Cased..... in..... ft.

Sand.....

Gas.....

Oil.....

Total Depth.....

Rig Up.....

Drilling Remarks

.....

.....

PRODUCTION

1st 24 hrs. Nat.....

1st 24 hrs. after shot.....

Gas..... cu. ft.....

Dry Hole.....

Abandoned.....


Map No. KANSAS Sec. 11 Twp. 20 R. 5^W
Well No. 1 - June Farm
Mid-Kansas Company

_____ Ft. from N. Line

660 Ft. from S. Line

660 Ft. from E. Line

_____ Ft. from W. Line

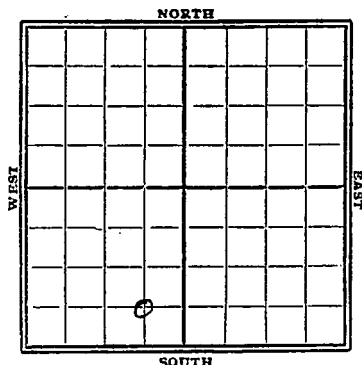

1929

Date

REPORT

7/2	<i>Reg</i>
7/10	
7/17	
7/24	<i>Reg up.</i>
7/31	<i>Spudding</i>
8/7	<i>Wrlg 420'</i>
8/14	<i>SD 775'</i>
8/21	<i>Show gas 1010-40. Wrlg 1075'</i>
8/28	<i>Wrlg 1520</i>
9/4	<i>" 2140</i>
9/11	<i>" 2445</i>
9/18	<i>" 2730</i>
9/25	<i>" 2835</i>
	<i>210" 2795</i>
10/2	<i>WRL 8"- 3010'</i>
10/9	<i>Wrlg 3020'</i>
10/16	<i>" 3150</i>
10/23	<i>No report</i>
10/30	<i>Wrlg 31520' 8"- 3433'</i>
11/6	<i>WRL 8"- 3665'</i>
11/13	<i>WRL 6"- 3672</i>
11/20	<i>Wrlg 3770</i>

11/27- Base Miss line 3710
HFW 3978'
Dry 4000'

12/4- TD. 4054'
Dry & Abandon

Map No. **KANSAS** Sec. 11 Twp. 20 R. 5W
 Well No. 48 1. Kans.

Mich. Kansas O & G Company
 Contractor

SECTION PLAT

.....Ft. from N. Line

660 Ft. from S. Line

660 Ft. from E. Line

.....Ft. from W. Line

	0		

FIRST REPORTS

Location.....✓

Rig up.....

Drilling and Remarks:

RECORD

Cased.....in.,ft.

Sand.....

Gas.....

Oil.....

Total Depth.....

PRODUCTION

1st 24 hrs. Nat.....

1st 24 hrs. after shot.....

Gas.....Cu. Ft.

Dry Hole.....

Abandoned.....

Date

JUL 2 1929
 192

S. J. LEWIS

Scout

*M. Pherson.*Map No. **KANSAS** Sec. 11 Twp. 20 R. 5W48Well No. 1 Huns.Mid-Kansas Oil & G. Company

Contractor

SECTION PLAT

.....Ft. from N. Line

660 Ft. from S. Line660 Ft. from E. Line

.....Ft. from W. Line

	0.		

ABANDONED

Location.....

Rig up.....

Drilling and Remarks:

RECORD

Cased.....in.,ft.

Sand.....

Gas.....

Oil.....

Total Depth 4054

PRODUCTION

1st 24 hrs. Nat.....

1st 24 hrs. after shot.....

Gas.....Cu. Ft.

Dry Hole.....

Abandoned.....

Date

DEC 4 1929
192S. J. LEWIS Scout