


Section 11 Township 20 Range 3W

Well No. ~~#1~~ #2 Krehbiel

Company Texas Pacific *Robert L. Jones*

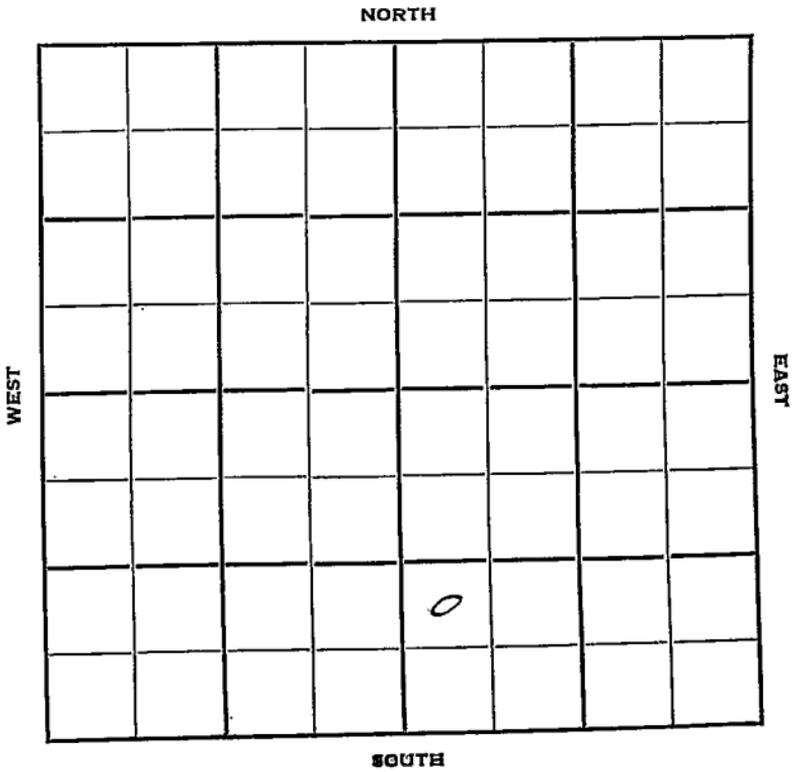

O.W.W.O.

McPherson

KANSAS ✓

Sec. 11 Twp. 20 R. 3W

Well No. #2 Krehbiel Farm

~~Texas Pacific~~ Robert L. Jones Company

Trans. Engr
~~Mallard Drlg.~~ Contractor


_____ Ft. from N. Line

990' Ft. from S. Line

_____ Ft. from E. Line

330' Ft. from W. Line

NW SW SE

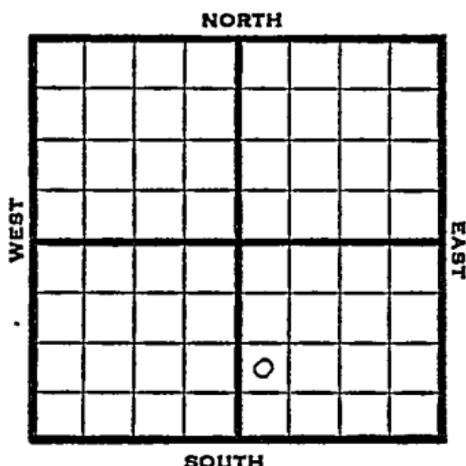

1950

Elev 1495' REPORT

3/29

Location

4/26

TD 3596'
 10" @ 215'
 Lans 2380'
 DST 2380-2426 opn 1 hr
 Rec 92' mud & wtr.
 KC 2474
 Miss 3012'
 DST 3016-54 opn 75 mins.
 Rec 480' oil & gas cut mud
 240' oil cut salt wtr.
 240' wtr.
 DST 3041-68 opn 1 hr
 Rec 720' fluid
 Est 250' OCM
 290 salt wtr.
 180' wtr.
 Hunton 3406'
 Viola 3470'
 Simp 3505'
 DST 3502-23 opn 75 mins.
 Rec 420' oil & gas cut mud
 DST 3529-35
 Rec wtr.
 TD 3596'
 D&A
 Aband.

ABANDONED

(over)

1956
4/4

O.W.W.O.

OTD 3596'

Comm. 3-28-56. DD 3601' 5 $\frac{1}{2}$ " @ ?

Tops: KC 2474', M. 3012', Hunton 3406'

V. 3470', S. 3505'

5-23

CO 3565- 24/3514-20, tst 8 goph, 12 hr

S/ 1 $\frac{1}{2}$ boph, no/wtr., frac

S/ 15 boph, no/wtr., 5 hrs.

P/ 3 boph

P/ 45 bopd, / 45 bwpd,

Grav. 30.1

P/ 25 bopd / 25 bwpd.

TD 3596'

COMPLETED

Map No. _____ Sec. 11 Twp. 20 R. 3WWell No. 2 Krehbiel

_____ Texas Pacific _____ Company

_____ Mallard Drlg. _____ Contractor

NW SW SE

_____ Ft. from N. Line

990 Ft. from S. Line

_____ Ft. from E. Line

330 Ft. from W. Line

SECTION PLAT

FIRST REPORT

McPherson County

Location X

Rig up _____

Drilling and Remarks:

RECORD

Cased _____ in., _____ ft.

Sand _____

Gas _____

Oil _____

Total Depth _____

PRODUCTION

1st 24 hrs. Nat. _____

1st 24 hrs. after shot _____

Gas _____ Cu. Ft.

Dry Hole _____

Abandoned _____

Date

MAR 29 1935J. E. TYRA Scout

Kansas

Map No. _____ Sec. 11 Twp. 20 R. 3W

Well No. 2 Krehbiel

Texas Pacific Company

Contractor _____

NW SW SE

E1. 1495
SECTION PLAT

_____ Ft. from N. Line

990 Ft. from S. Line

_____ Ft. from E. Line

330 Ft. from W. Line

McPherson County



RECORD

Location _____

Cased _____ in., _____ ft.

Rig up _____

Sand _____

Drilling and Remarks:

Gas _____

10" C 215
Lans. 2380

Oil _____

DST 2380-2426

Total Depth 3596

Open 1 hr.

Rec. 92' mud + water

PRODUCTION

K.C. 2474

1st 24 hrs. Nat. _____

Miss. 3012

1st 24 hrs. after shot _____

DST 3016-54

Gas _____ Cu. Ft.

Dry Hole _____

Abandoned _____

Date

APR 26 1950 19

J. E. TYRA

Scout

O.W.W.O.

FORM 513 SUNRAY

OWWO

County McPherson Elev. 1195
 Sec. 11 Twp. 20 Rge. 3W
 Company Robert L. Jones
 FarmName Krehbiel No. 2

TOPS	DEPTH	LOG	DATUM	Loc. in Sec.
Anh.				NW SW SE
TP.				
H.				
Tr.				
Dg.				
Bl.				
L.				Geol.
K.C.	<u>2171</u>			Contr.
B.K.C.				<u>Trans-Era</u>
Ce.				
C.				Pool
M.	<u>3012</u>			
M. <u>Hunton</u>	<u>3106</u>			
Kz.				
Mo.				
V.	<u>3170</u>			
S.				
S.	<u>3515</u>			
A.				
R.				
PE.				
G.				
T.D.	<u>3596</u>			

FIRST REPORT			
APR 4 '56			
0			

Date Comm. 3-28-56

OTD 3596 DD 301 5 1/2 @

[Handwritten signature]

GEO. C. ...

[Handwritten initials]

Co. No. Sec. T. R.

CORRECTION

FORM 513 SUNRAY

OKWO

County McPherson Elev. 1195
 Sec. 11 Twp. 20 Rge. 3W
 Company Robert I. Jones
 Farm Name Krehbiel No. 111

TOPS	DEPTH	LOG	DATUM	Loc. in Sec.																																	
Anh.				11W S11 S1E																																	
Tr.																																					
H.																																					
Tr.																																					
Dg.																																					
Bl.																																					
L.				Geol.																																	
K.C.	2174			Contr.																																	
B.K.C.				Trans-Era																																	
Ce.				<u>New Pay</u>																																	
C.				Pool																																	
M.	3012			<table border="1" style="width: 100%; height: 100%; border-collapse: collapse;"> <tr><td> </td><td> </td><td> </td></tr> </table>																																	
M.	3106																																				
K. Manton																																					
Mz.																																					
Me.																																					
V.	3170																																				
S.																																					
S.	3505																																				
A.																																					
R.																																					
PE																																					
G.																																					
TD	3596																																				

Date Comm. 3-28-56 MAY 23 1956
 OTD 3596 DD 3601 511E 6, APR 11 '56 3600/200

ca 3565 24/3514-20 1st 8 90ph
12hr & 1 1/2 Boph no/wtr Frac
& 15' Boph no/wtr 5 hrs Pop
 APR 18 '56 APR 25 '56 P 3 Boph MAY 2 '56
 MAY 9 '56 P. 4'5 Bopd + 45 Bwpd
 MAY 16 '56 MAY 23 '56 Grav 30.1°
 P. 25 Bopd + 25 Bwpd.