


# KANSAS

FORM 51 5M BR1X

Section 11 Township 20 Range 3W

Well No. 1 E. G. Decker

Company Bay Petroleum

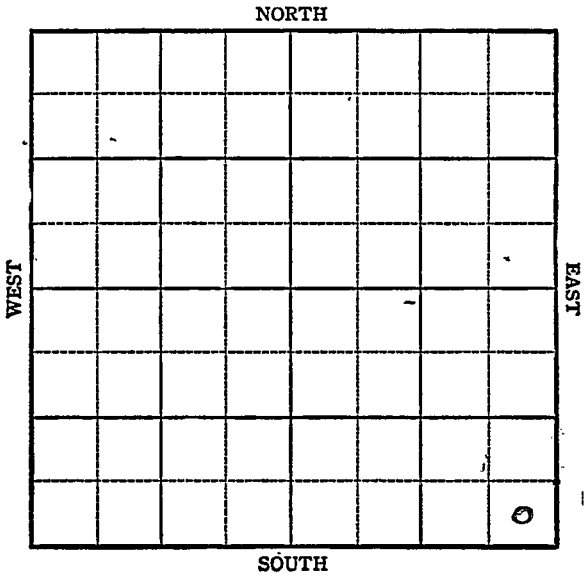

**KANSAS**

McPherson


Sec. 11 Twp. 20 R. 3W

Well No. #1 E G Decker Farm

Bay Petroleum Company

Johnson

NORTH

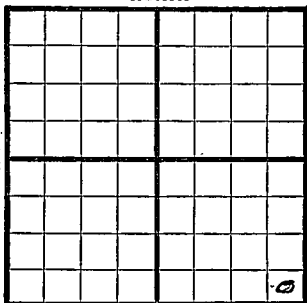

         Ft. from N. Line

330 Ft. from S. Line

330 Ft. from E. Line

         Ft. from W. Line

Blw. 1501

SOUTH

SE/C

1944

REPORT

8/30

Location

9/8

Drlg. 230

9/13

Drlg. 2190'

9/21

8" @ 230

Lans 2382

Miss 3018

Drlg. 3103

9/28

Drlg. 3561

10/4

Viola 3437

Simp sd 3561

TD 3596

5" @ 3596 RUST

10/11

12 shots 3561-65

1000' W in 3 hrs.

PB 3140

16 shots 3105-13 tstg.

10/18

Simp. Sd 3561

5" @ 3596

Perf. Wtr.

TD 3596

**ABANDONED**

KANSAS

Pool Name Johnson

Map No. 43 Sec. 11 Twp. 20 R. 3W

Well No. 1 E. G. Decker

Bay Petroleum Company

FIRST REPORT Contractor

SE/C

SECTION PLAT

           Ft. from N. Line

350 Ft. from S. Line

350 Ft. from E. Line

           Ft. from W. Line


McPherson County

Location X

Rig up           

Drilling and Remarks:

RECORD

Cased            in,            ft.

Sand           

Gas           

Oil           

Total Depth           

PRODUCTION

1st 24 hrs. Nat.           

1st 24 hrs. after shot           

Gas            Cu. Ft.

Dry Hole           

Abandoned           

Date

AUG 30 1944 19

S. J. LEWIS Scout

