


KANSAS McPherson

Section 12 Township 20 Range 2WWell No. 1 HolmesCompany P C ReynoldsRitz-Canton  
NORTH

KANSAS

McPherson

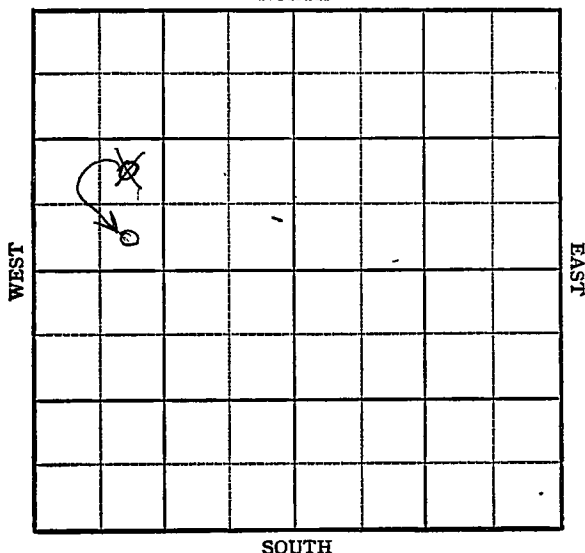

Sec. 12 Twp. 20 R. 2W

Well No. #1 Holmes Farm

P. G. Reynolds

Company


Ritz-Canton

       Ft. from N. Line

~~990'~~ 370 Ft. from S. Line

       Ft. from E. Line

990' Ft. from W. Line

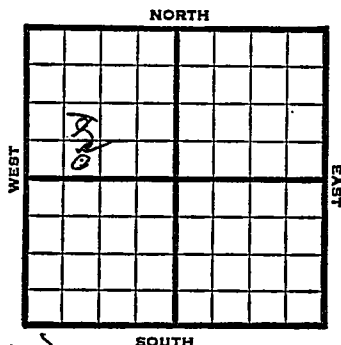

~~NE SW NW~~ SE SW NW

1949 Elev 1548' REPORT

|      |                                                                             |
|------|-----------------------------------------------------------------------------|
| 2/2  | Spud                                                                        |
| 2/9  | 8" @ 106'<br>Drlg. 2600'                                                    |
| 2/16 | Chat 2961'<br>5" @ 2964 TD                                                  |
| 2/23 | "                                                                           |
| 3/2  | "                                                                           |
| 3/8  | "                                                                           |
| 3/16 | "                                                                           |
| 3/22 | "                                                                           |
| 3/30 | "                                                                           |
| 4/6  | "                                                                           |
| 4/12 | TD 2977'                                                                    |
| 4/20 | "                                                                           |
| 4/27 | TD 2986'                                                                    |
| 5/4  | 600' oil & 1200' wtr.                                                       |
| 5/11 | TD 2986' ,<br>Chat 2951'<br>5 @ 2964'<br>Pump 50 Oil Pot<br>39° Gr.<br>Comp |

**COMPLETED**

Map No. \_\_\_\_\_ Sec. 12 Twp. 20 R. 2W

Well No. 1 Holmes

P. G. Reynolds Company

FIRST REPORT Contractor

NE SW NW

SECTION PLAT

|  |  |  |  |
|--|--|--|--|
|  |  |  |  |
|  |  |  |  |
|  |  |  |  |
|  |  |  |  |

\_\_\_\_\_ Ft. from N. Line

990 Ft. from S. Line

\_\_\_\_\_ Ft. from E. Line

990 Ft. from W. Line

McPherson County

Location \_\_\_\_\_

Rig up \_\_\_\_\_

Drilling and Remarks:

Spud

RECORD

Cased \_\_\_\_\_ in., \_\_\_\_\_ ft.

Sand \_\_\_\_\_

Gas \_\_\_\_\_

Oil \_\_\_\_\_

Total Depth \_\_\_\_\_

PRODUCTION

1st 24 hrs. Nat. \_\_\_\_\_

1st 24 hrs. after shot \_\_\_\_\_

Gas \_\_\_\_\_ Cu. Ft.

Dry Hole \_\_\_\_\_

Abandoned \_\_\_\_\_

Date

FEB 2 1949 19

S. J. LEWIS

Scout

Map No. \_\_\_\_\_ Sec. 12 Twp. 20 R. 2WWell No. 1 Holmes

P. G. Reynolds


Company

CORRECTION

Contractor

SE SW NW

## SECTION PLAT

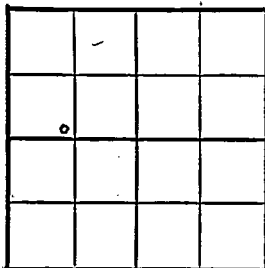

\_\_\_\_\_ Ft. from N. Line

330 Ft. from S. Line

\_\_\_\_\_ Ft. from E. Line

990 Ft. from W. Line

McPherson County

Location \_\_\_\_\_

Rig up \_\_\_\_\_

Drilling and Remarks:

Reported

NE SW NW

## RECORD

Cased \_\_\_\_\_ in., \_\_\_\_\_ ft.

Sand \_\_\_\_\_

Gas \_\_\_\_\_

Oil \_\_\_\_\_

Total Depth \_\_\_\_\_

## PRODUCTION

1st 24 hrs. Nat. \_\_\_\_\_

1st 24 hrs. after shot \_\_\_\_\_

Gas \_\_\_\_\_ Cu. Ft.

Dry Hole \_\_\_\_\_

Abandoned \_\_\_\_\_

Date

MAR 2 1949 19

S. J. LEWIS

Scout

Kansas

Map No. 4-3 ~~K 24~~ Sec. 12 Twp. 20 R. 2WWell No. 1 HolmesP. G. Reynolds Company**COMPLETE**

Contractor

SE SW NW

*E. 1548*  
**SECTION PLAT**

|  |  |  |  |
|--|--|--|--|
|  |  |  |  |
|  |  |  |  |
|  |  |  |  |
|  |  |  |  |

Ft. from N. Line

330

Ft. from S. Line

Ft. from E. Line

990

Ft. from W. Line

McPherson County

Location \_\_\_\_\_

Rig up \_\_\_\_\_

Drilling and Remarks:

*Okay 2951**5" @ 2964**Run 50 oil Rod**292 1/2***RECORD**

Cased \_\_\_\_\_ in., \_\_\_\_\_ ft.

Sand \_\_\_\_\_

Gas \_\_\_\_\_

Oil \_\_\_\_\_

Total Depth 1996**PRODUCTION**

1st 24 hrs. Nat. \_\_\_\_\_

1st 24 hrs. after shot \_\_\_\_\_

Gas \_\_\_\_\_ Cu. Ft.

Dry Hole \_\_\_\_\_

Abandoned \_\_\_\_\_

Date

MAY 11 1949 19S. J. LEWIS

Scout