

McPherson

FORM 51 IOM 12-46 PETROL


KANSAS

Section 12 Township 20 Range 2W

Well No. 6 Munn

Company Bennett & Abel

Ritz-Canton NORTH

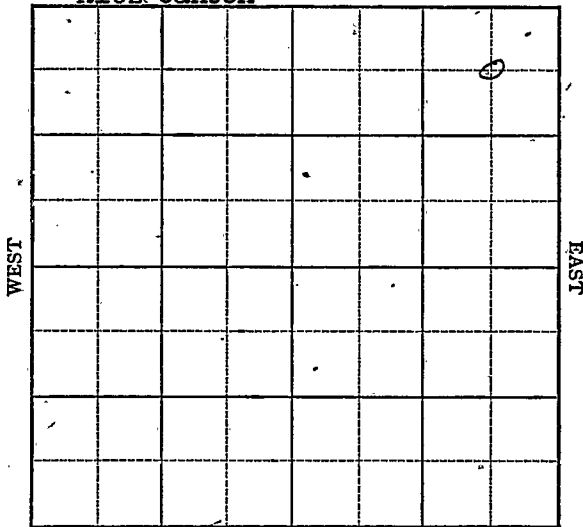

SOUTH

Sec. 12 Twp. 20 R. 2W

Well No. 6 Munn Farm
Bennett & Abel Company


Ritz-Canton

660 Ft. from N. Line

 Ft. from S. Line

660 Ft. from E. Line

 Ft. from W. Line

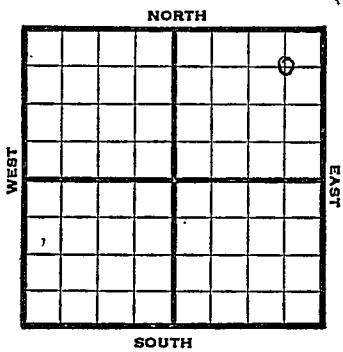

C NE NE

1947 Elev. 1548' REPORT

4/30 10" @ 134
Drlg. 746'.

5/7 Lansing 2255'
Drlg. 2600'.

5/14 Viola 3389'
TD 3410'

ABANDONED

Map No. K43 Sec. 12 Twp. 20 R. 2W

Well No. 6 Munn

Bennett & Abel Company

FIRST REPORT Contractor

C NE NE

SECTION PLAT

660 Ft. from N. Line

_____ Ft. from S. Line

660 Ft. from E. Line

_____ Ft. from W. Line

			o

McPherson County

Location _____

Rig up _____

Drilling and Remarks:

10" @ 134

drlg. 746

RECORD

Cased _____ in., _____ ft.

Sand _____

Gas _____

Oil _____

Total Depth _____

PRODUCTION

1st 24 hrs. Nat. _____

1st 24 hrs. after shot _____

Gas _____ Cu. Ft.

Dry Hole _____

Abandoned _____

Date

APR 30 1947 19

S. J. LEWIS Scout

Map No. 143 Sec. 12 Twp. 20 R. 2W

Well No. 6 Minn

Bennett & Abel Company

ABANDONED

Contractor

C NE NE

E/1548

SECTION PLAT

660 Ft. from N. Line

_____ Ft. from S. Line

660 Ft. from E. Line

_____ Ft. from W. Line

			5

McPherson County

Location _____

Rig up _____

Drilling and Remarks:

Via 3389

RECORD

Cased _____ in., _____ ft.

Sand _____

Gas _____

Oil _____

Total Depth 9410

PRODUCTION

1st 24 hrs. Nat. _____

1st 24 hrs. after shot _____

Gas _____ Cu. Ft.

Dry Hole _____

Abandoned _____

Date

MAY 14 1947 19

S. J. LEWIS

Scout