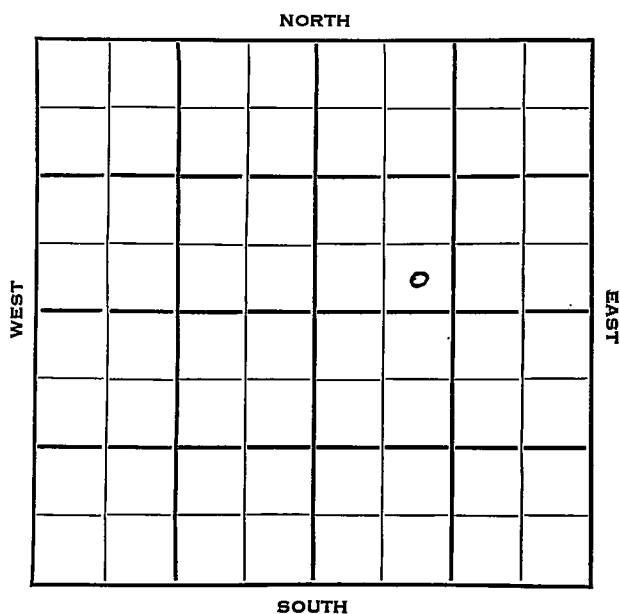


Section 12 Township 20 Range 6WWell No. #1 C^oupCompany J. W. Braden Oil

Rice

KANSAS

Sec. 12 Twp. 20 R. 6W

Well No. #4 Coup Farm

J. W. Braden Oil Company

Braden Contractor

Welch-Barnholdt


Ft. from N. Line

330 Ft. from S. Line

Ft. from E. Line

990 Ft. from W. Line

SE SW NE

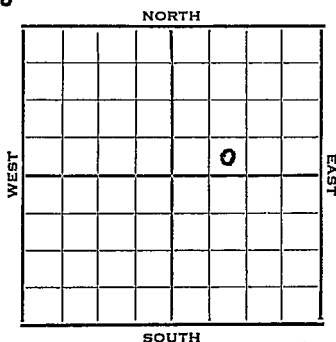

1953 Elev. 1584' REPORT

7/11 Location

7/22 8" @ 157 w/100
Drlg. 2480'


7/29 Miss 3354' TD 3359'
5" @ 3356 Lans 2774 Cong 3293'

8/5 DD 3382' TD Sd-frac.

8/12 Spud 7-16-53
Oil Well
TD 3382'
8" @ 151'
Miss 3354, Lans 2774, Cong 3293
TD 3359'
5" @ 3356'
DD 3382
sd-frac.
Comp. 30 bopd 25% wtr.

COMPLETED

County Rice State Kansas
 Sec. 12 (Blk. 20) (Sur. 6W) (Twp. Map No.)
 Operator J. W. Braden Oil
 Well No. 4 Farm Coup
 Elev. _____ Location SE SW NE

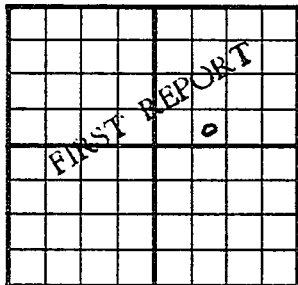

330 Ft. From S Line NE
990 Ft. From W Line Quarter
 1st. Report JUL 1 4 1953
 Completion _____
 Remarks _____
Braden - Contr.
 Spudding Date _____

Drig. Data Welch-Barnholdt

Location

J. G. McGEHEE

J. G. McGEHEE