


Rice

KANSAS

Section 12 Township 20 Range 6-W

Well No. #1 Kidd

Company W. L. Hartman et al

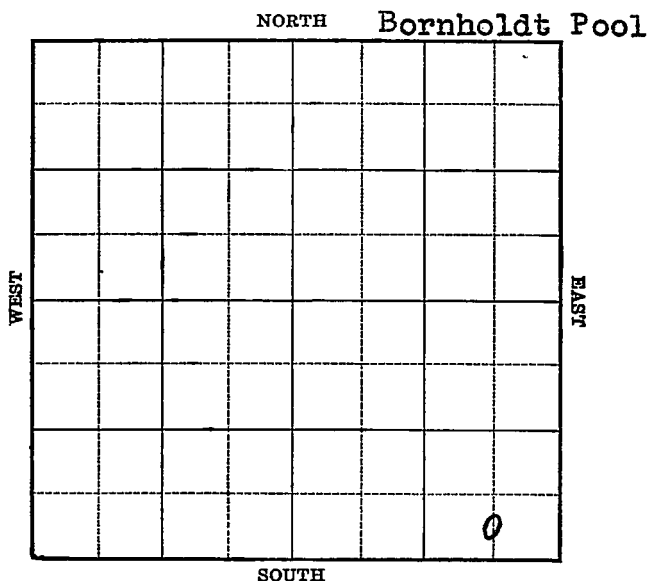

Map No. 48 Sec. 12 Twp. 20 R. 6WWell No. 1 KiddW. L. Hartman et al Company

Contractor

FIRST REPORT

C S L SE SE

 Ft. from N. Line330 Ft. from S. Line660 Ft. from E. Line Ft. from W. Line

SECTION PLAT

BORNHOLDT POOL

Location Rig up

Drilling and Remarks:

Derrick

RECORD

Cased in., ft.Sand Gas Oil Total Depth

PRODUCTION

1st 24 hrs. Nat. 1st 24 hrs. after shot Gas Cu. Ft.Dry Hole Abandoned

Date

FEB 1 1940 19

S. J. LEWIS Scout

Map No. 48 Sec. 12 Twp. 20 R. 6WWell No. 1 KiddW. L. Hartman et al Company

Contractor

COMPLETED
C S L SE SE

SECTION PLAT

			o

 Ft. from N. Line330 Ft. from S. Line660 Ft. from E. Line Ft. from W. Line

BORNHOLDT POOL

Location Rig up

Drilling and Remarks:

*Chas 3301**5" @ 330 1/2**Depthograph by*
1112

RECORD

Cased in., ft.Sand Gas Oil Total Depth 3358

PRODUCTION

1st 24 hrs. Nat. 1st 24 hrs. after shot Gas Cu. Ft.Dry Hole Abandoned

Date

APR 3 1940 19

S. J. LEWIS Scout