


Section 13 Township 20 Range 3W

Well No. #1 Krehbiel

Company W. J. Coppinger

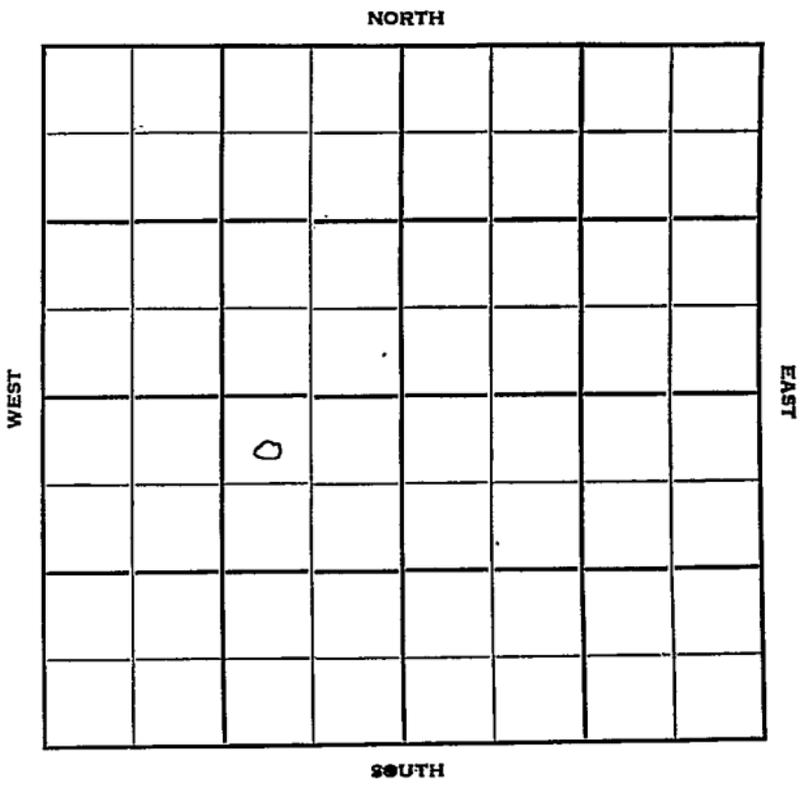

Sec. 13 Twp. 20 R. 3W

Well No. #1 Krehbiel Farm

W. J. Coppinger Company

Contractor

Wildcat


330 Ft. from N. Line

_____ Ft. from S. Line

990 Ft. from E. Line

_____ Ft. from W. Line

NW NE SW

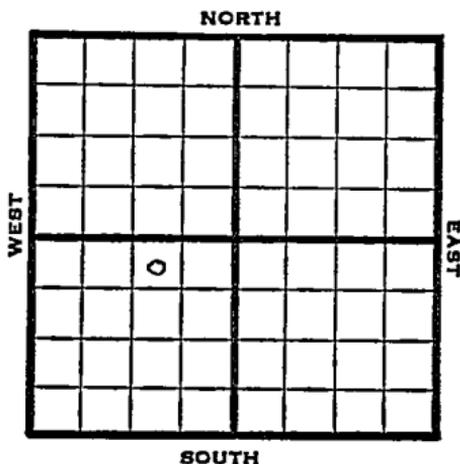

1951 Elev. 1473' REPORT

12/5 Spud 11-25-51
8" @ 150'
Drlg. 3039'

12/12 Spud 11-25-51
D&A TD 3078
8" @ 150
Lans. 2375 Miss 3033
DST 3032-38 opn 1 hr Rec. 120' mud
90' socm TD 3078
D&A

ABANDONED


County McPherson State Kansas

Sec. 13 (^{Blk.}_{Twp.}) 20 (^{Sur.}_{Rge.}) 3W Map No.

Operator W. J. Coppinger

Well No. 1 Farm Krehbiel

Elev. 1473 Location NW NE SW

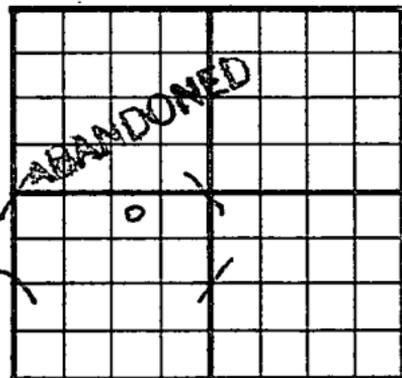

330 Ft. From N Line SW

990 Ft. From E Line Quarter

1st. Report

Completion DEC 1 2 1951

Remarks Wildcat

Spudding Date 11-25-51

Drig. Data D & A TD 3078

8" @ 150 Lans. 2375 Miss. 3033

DST 3032-38 open 1 hr. Rec. 120' mud

90' socm. TD 3078

D & A

J. E. TYRA