

Rice

KANSAS

SECTION 13 TOWNSHIP 20 RANGE 6W

WELL NO. #4 Wright

COMPANY Bradley Bros.

NORTH

WEST

EAST

					0		

SOUTH

Rice

KANSAS

SEC.	TWP.	R.
13	20	6W

WELL NO.

#4 Wright

FARM

COMPANY

Bradley Bros.

CONTRACTOR

Welch-Bornholdt


Ft. from N. Line

Ft. from S. Line

Ft. from E. Line

Ft. from W. Line

NE NW SE

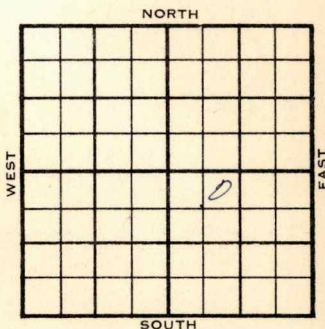

1956

ELEVATION

1560'

REPORT

4-18

Location

5-23

Comm. 4-24-56

8 5/8" @ 149 w/125

5 1/2" @ 3287 w/125

DD 3331

S/ 17 BOPH, no/wtr., 2 hrs., 600' O.B.

P/ 50 bopd, no/wtr.,

Comp. P/25 bopd, no/wtr.

M. 3282'

TD 3288'

COMPLETED

County Rice Elev. _____
 Sec. 13 Twp. 20 Rge. 6W
 Company Bradley Bros.
 Farm Name Wright No. 4

Co.

Lse.

No.

Sec.

T.

R.

TOPS	DEPTH	LOG	DATUM
Anh.			
Tr.			
H.			
Tr.			
Dg.			
Bl.			
L.			
K.C.			
B.K.C.			
Ce.			
C.			
M.			
M.			
K.			
Mz.			
Mo.			
V.			
S.			
S.			
A.			
R.			
Pe.			
G.			
T.D.			

Loc. in Sec.

NE NW SE

Geol.

Contr.

Pool

Welch-Bornholdt

FIRST REPORT	
0	
APR 18 1955	

Date Comm.

Location

APR 24 1955

R. G.

12

County Rice Elev. 1560
 Sec. 13 Twp. 20 Rge. 6W
 Company Bradley Bros.
 Farm Name Wright No. 1

TOPS	DEPTH	LOG	DATUM	Loc. in Sec.
Anh.				NE NW SE
Tp.				
H.				
Tr.				
Dg.				
Bl.				
L.				Geol.
K.C.				Contr. <u>Braden</u>
B.K.C.				
Ce.				
C.				
M.	<u>3282</u>			Pool
M.				<u>Welch-Bornholdt</u>
K.				
Mz.				
Mo.				
V.				
S.				
S.				
A.				
R.				
Pe.				
G.				
TD	<u>3288</u>			

COMPLETE

Date Comm.

MAY 23 1956

Location APR 25 '56 MIR MAY 2 '56

4-24-56 P5/8 149/125 @ 3100

MAY 9 '56 5 1/2 @ 3287/125 Co DD 3331

550 Frac & 17 Bopd no/w

2 hrs 600 O.B. Pop MAY 16 '56 MAY 23 '56

P. 50 Bopd no/w complete

P. 25 Bopd no/w