


Section 13 Township 20 Range 2WWell No. #1 KoehnCompany Glickman & Boga

NORTH

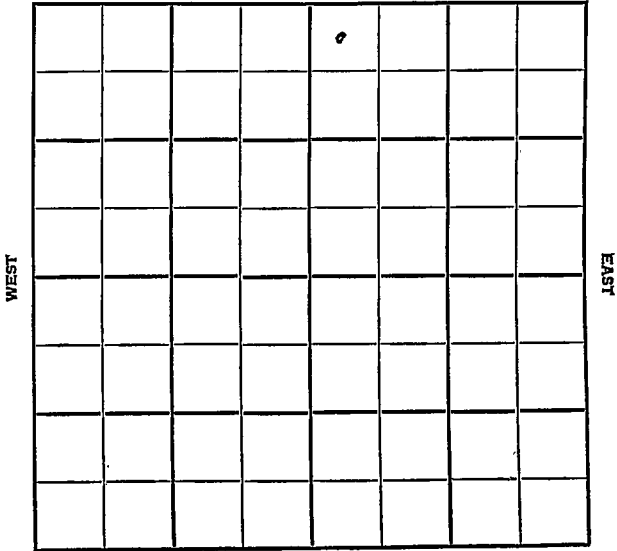

SOUTH

SEC.	TWP.	R.
13	20	2W

WELL NO.

#1 Koehn

FARM

COMPANY

Glickman & Boge

CONTRACTOR

Melland Tools.

Ritz Canyon Pool

NORTH

330

Ft. from N. Line


Ft. from S. Line

Ft. from E. Line

330

Ft. from W. Line

NW NW NE

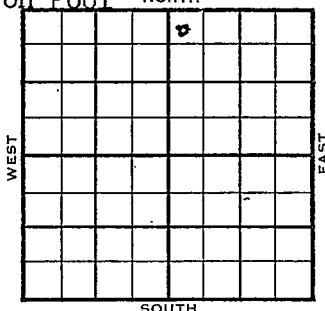

	ELEVATION	REPORT
1954	1537'	
9/29	Spud 9-27-54 8" @ 152'	
10/20	WOC. Spud 9-27-54 Oil Well TD 2986' 8" @ 152' KC 2294', Miss 2925 , DST 2928'-34' opn 1 hr. gas in 4 min rec 500' oil 455# DST 2939'-86' opn 1/2 hr, rec 60' ocm, 270' Muddy oil, 870' s.w. 622# TD 2986' DST 2952'-66' opn 1 hr, rec 145' so & gcmw 467# 5" @ 2984' 20/ 2923-26 F/ 1 boph 700,000 cfgpd. Comp 24 bopd. 700,000 cfg	
		COMPLETED

DX-78

FABEN GILSTRAP

County McPherson State Kansas
 Sec. 13 (Blk. 20) (Sur. 2W) Map No.
 Operator Glickman & Boge
 Well No. 1 Farm Koehn
 Elev. 1537 Location NW NW NE

330 Ft. From N Line NE330 Ft. From W Line Quarter1st. Report Completion OCT 20 1954

Remarks Ritz-Canton Pool
Melland - Contr.

Spudding Date 9-27-54Drlg. Data Oil well TD 29868" @ 152 KC 2294 Miss. 2925DST 2928-34 open 1 hr. gas in 4 min.Rec. 500' oil 455# DST 2939-86open $\frac{1}{2}$ hr. Rec. 60' ocm 270' muddy oil870' sw 622# TD 2986 DST 2952-66open 1 hr. Rec. 145' so & gcmw 467#5" @ 2984 20/ 2923-26 F/ 1 boph700,000 cfigpd Comp. 24 bopd 700,000 cfig

FABEN GILSTRAP