

DX 78-1


McPherson KANSAS

Section 13 Township 20 S Range 2 W

Well No. # 3 Koehn

Company Glickman & Boge

NORTH

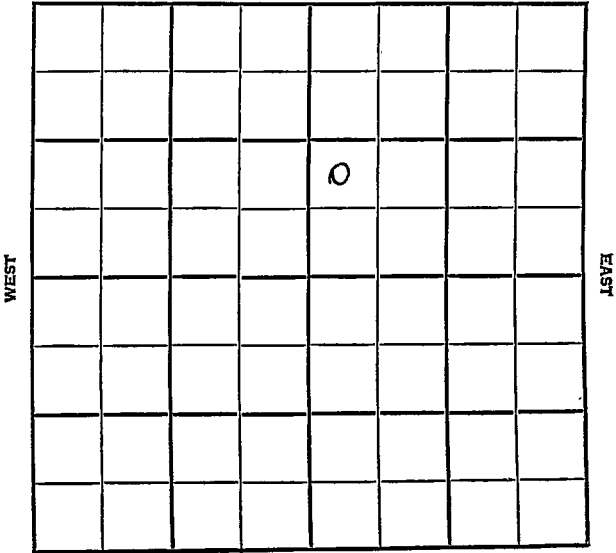

SOUTH

McPherson

KANSAS

SEC.	TWP.	R.
13	20S	2W

WELL NO.

#3 Koehn

FARM

COMPANY

Glickman & Boge.

CONTRACTOR

Melland Tools.

Ritz-Canton

NORTH

Ft. from N. Line

990

Ft. from S. Line

Ft. from E. Line

330

Ft. from W. Line

WEST

EAST

SOUTH

NW SW NE

1954	ELEVATION 1540'	REPORT
------	--------------------	--------

12/8

8" @ 150'

WOR.

1955

1/5

Spud 12-10-54

Oil Well

TD 2971'

8" @ 150'

Miss 2929'

DST 2930'-43' opn 40 min, gas in 2 min

F/ oil in 35 min, rec 510' clean oil

520#

TD 2971'

5" @ 2968'

CO to 2971'

1000 A frac.

Comp 45 bopd. 25 bw.

COMPLETED

