


DX 78-1

McPherson KANSAS

Section 13 Township 20 Range 2nd

Well No. 2 T. Koehn

Company Casebeer & Liton

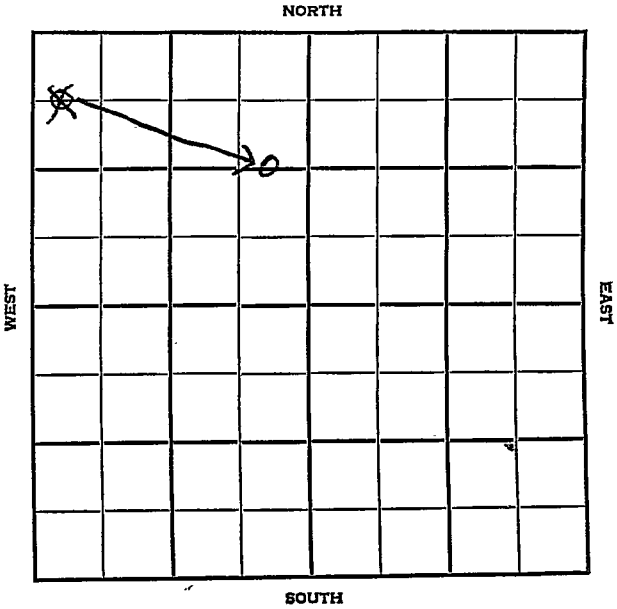


SEC.	TWP.	R.
13	20	2W

WELL NO. #2 T. Koehn FARM

COMPANY Casebeer & Liten

CONTRACTOR Melland
Ritz-Canton

1320 Ft. from N. Line
 _____ Ft. from S. Line
330 Ft. from E. Line
 _____ Ft. from W. Line
 C E $\frac{1}{2}$ ~~NW~~ ^{E/2} NW

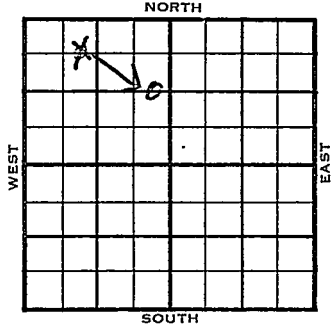

1955	ELEVATION 1533'	REPORT
------	--------------------	--------

7/27 Comm 7-21-55
 8" @ 140/110
 Drlg 1850

8/17 TD: 2963, 5" @2959 DD 2965, B/5 bopd
 2 bwph, Frac Comp: 10 bopd 40-bw.
 M. CH: 2933, 1400, TD: 2963

COMPLETED

County McPherson Elev. _____
 Sec. 13 Twp. 20 Rge. 2W
 Company Casebeer & Liten
 Farm Name T. Koehn No. 2

Co.
Lse.
No.
Sec.
T.
R.

TOPS	DEPTH	LOG	DATUM
Anh.			
Tp.			
H.			
Tr.			
Dg.			
Bl.			
L.			
K.C.			
B.K.C.			
Ce.			
C.			
M.			
M.			
K.			
Mz.			
Ma.			
V.			
S.			
S.			
A.			
R.			
PE.			
G.			
T.D.			

Loc. in Sec. C E $\frac{1}{2}$ NW NW
 Geol. _____
 Contr. _____
Melland
 Pool _____
Ritz-Canton

0		
FIRST REPORT		
JUL 27 '55		

Date Comm. 7-21-55
8" @ 140/110 drlg. 1850

