


Map No. KANSAS Sec. 13 Twp. 20 R. 2^w
Well No. 1-McPherson College Barley Pit Barley Company

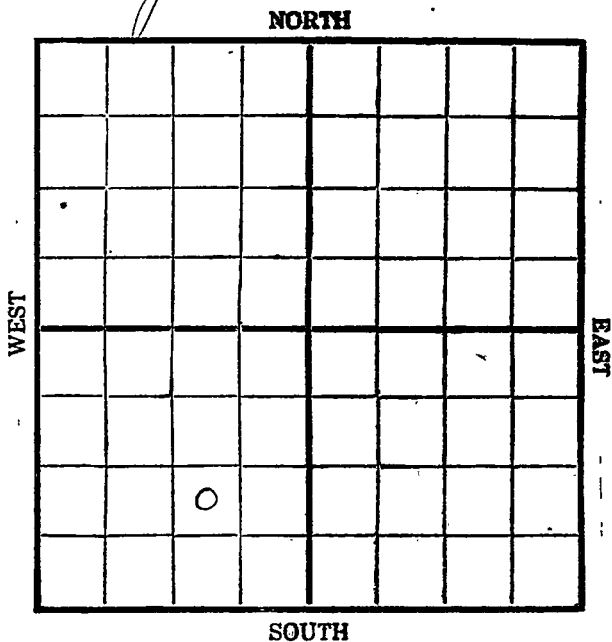

Location _____

Drilling Remarks _____

Rig Up _____

Drilling Remarks _____

RECORD

Cased _____ in. _____ ft.

Sand _____

Gas _____

Oil _____

Total Depth _____

PRODUCTION

1st 24 hrs. Nat. _____

1st 24 hrs. after shot _____

Gas _____ cu. ft.

Dry Hole _____

Abandoned _____


Map No. KANSAS Sec. 13 Twp. 20 R. 2W
 Well No. 1-M^cPherson College Farm
Darby Pet Corp Company

_____ Ft. from N. Line

990 Ft. from S. Line

990 Ft. from E. Line

_____ Ft. from W. Line

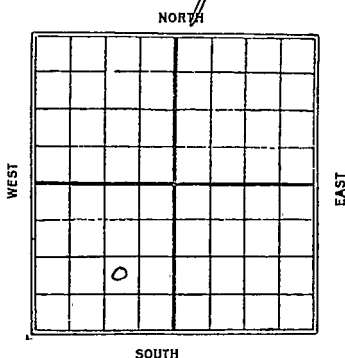

1929

Date	REPORT
<u>11/6</u>	<u>Location</u>
<u>11/13</u>	<u>ROC</u>
<u>11/20</u>	<u>—</u>
<u>11/27</u>	<u>—</u>
<u>12/4</u>	<u>—</u>
<u>12/11</u>	<u>Big</u>
<u>12/18</u>	<u>Ran up</u>
<u>12/23</u>	<u>Only 425'</u>
<u>12/30</u>	<u>" 1000'</u>
<u>1930</u>	
<u>1/8</u>	<u>Fsg tools 1700'</u>
<u>1/15</u>	<u>—</u>
<u>1/22</u>	<u>—</u>
<u>1/29</u>	<u>Run 12 1/2" - 1700' Ch. out</u>
<u>2/5</u>	<u>A7W 2100 - Dlg 2113</u>
<u>2/12</u>	<u>UIR 10" - 2280'</u>
<u>2/19</u>	<u>A7W - 2425 - 35 - Dlg</u>
	<u>2505</u>
<u>2/26</u>	<u>8" - 2764 - Dlg. 2775.</u>
<u>3/5</u>	<u>Top Shat 2948 A7W</u>
	<u>2977-85 T.D. 2990</u>
	<u>UIR 8"</u>

3/12- Hrlg. 3030.
3/19- Slg. out 3030'
8" at 2990'

3/26- Base Miss. line
3200 - set 6"
Hrlg. 3225'

4/2- Top Viola 3400 - show
oil 3403 water 3407
Hrlg.

4/9- Silc. line 3510-35
2 1/2" 6"

4/16- 3600- Run 5"

4/23- Top. Sil. 3475'
Hrlg. ~~3400~~

4/30 T.D. 3673

Abandoned

Map No. KANSAS Sec. 13 Twp. 20 R. 2 WWell No. 43 McPherson CollegeHarty & Co. Company

Contractor

SECTION PLAT

.....Ft. from N. Line

990 Ft. from S. Line990 Ft. from E. Line

.....Ft. from W. Line

FIRST REPORTS

Location ✓

Rig up.....

Drilling and Remarks:

RECORD

Cased.....in.,ft.

Sand.....

Gas.....

Oil.....

Total Depth.....

PRODUCTION

1st 24 hrs. Nat.....

1st 24 hrs. after shot.....

Gas.....Cu. Ft.

Dry Hole.....

Abandoned.....

Date

NOV 6 1929 S. J. LEWIS Scout

Map No. KANSAS Sec. 13 Twp. 20 R. 2W

Well No. 1stst Person College

Harry P. S. Corp. Company

Contractor

SECTION PLAT

Ft. from N. Line

990 Ft. from S. Line

990 Ft. from E. Line

Ft. from W. Line

ABANDONED

Location

Rig up

Drilling and Remarks:

RECORD

Cased in., ft.

Sand

Gas

Oil

Total Depth 3673

PRODUCTION

1st 24 hrs. Nat.

1st 24 hrs. after shot

Gas Cu. Ft.

Dry Hole

Abandoned

Date

APR 30 1930

S. J. LEWIS Scout