

McPherson


KANSAS

FORM 51 25M 3-49 PETROL

Section 13 Township 20 Range 1W

Well No. #1 Dirkson

Company National Assoc. Pet.

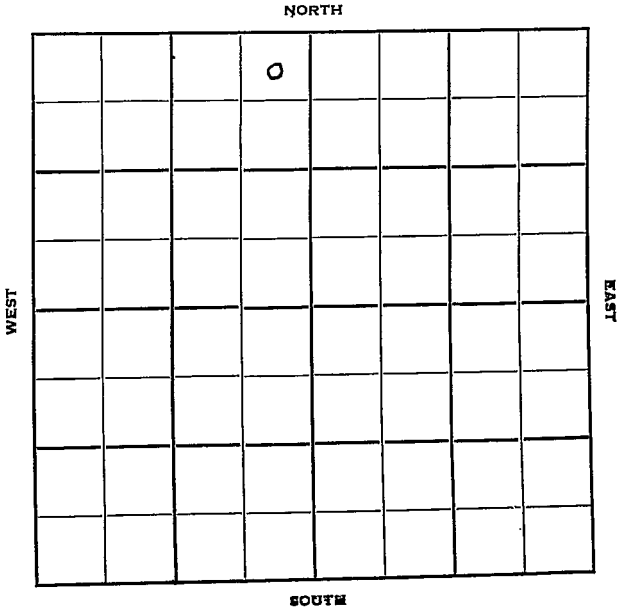

Sec. 13 Twp. 20 R. 1W

Well No. #1 Dirkson Farm

National Assoc. Pet. Company

Beardmore - Contr. Contractor

Semi-Wildcat


330' Ft. from N. Line

 Ft. from S. Line

330' Ft. from E. Line

 Ft. from W. Line

NE NE NW

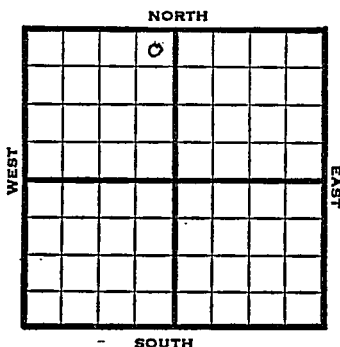

1950 Elev 1515 REPORT

10/18 Spud 10-14-50
8" @ 116'
Drlg. 670'

11/1 8" @ 116
Lans 2352 Miss 2933
DST 2935-70 opn 1 hr rec 30' mud
DST 2960-85 TD opn 1 hr rec 120' m&w
TD 2985
D&A

ABANDONED

County McPherson State KansasSec. 13 (Blk. Twp.) 20 (Sur. Rge.) 1W Map No.Operator National Assoc Pet.Well No. 1 Farm DirksonElev. Location NE NE NW

		0				


330 Ft. From N Line NW330 Ft. From E Line Quarter1st. Report OCT 18 1950

Completion

Remarks

Beardmore - Contr.Spudding Date 10-14-50Drlg. Data Semi Wildcat8" @ 116 drlg. 670

J. E. TYRA

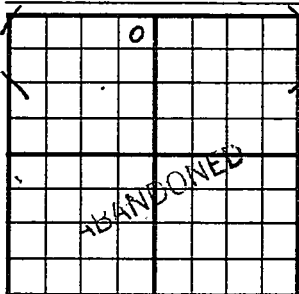County McPherson State KansasSec. 13 (^{Blk.}Twp.) 20 (^{Sur.}Rge.) 21W Map No.Operator National Assoc. Pet.Well No. 1 Farm DirksonElev. 1515 Location NE NE NW330 Ft. From N Line NW330 Ft. From E Line Quarter1st. ReportCompletion NOV 1 1950Remarks Semi WildcatBeardmore - Contr.Spudding Date 10-14-50Drlg. Data D & A TD 29858" @ 116 Lans. 2352 Miss. 2933DST 2935-70 open 1 hr. Rec. 30' mudDST 2960-85 TD open 1 hr. Rec. 120' m & wD & A

J. E. TYRA