

Rice


KANSAS

SECTION 13 TOWNSHIP 20 RANGE 6W

WELL NO. #2 Swanson "A"

COMPANY Braden Drlg.

NORTH

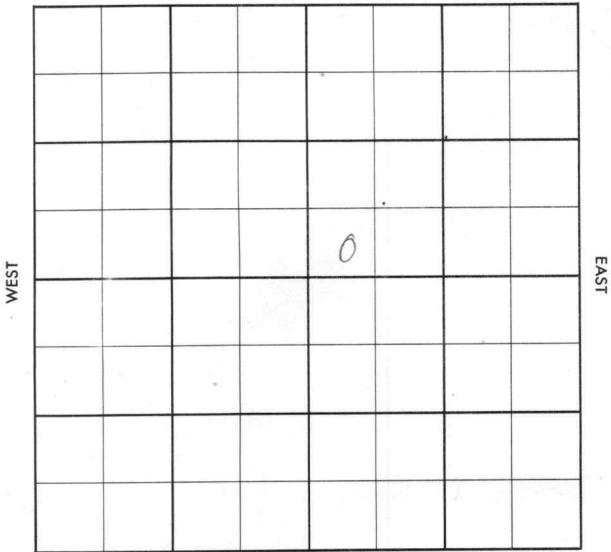

SOUTH

County Rice Elev. _____
 Sec. 13 Twp. 20 Rge. 6W
 Company Braden Drig.
 Farm Name Swanson "A" No. 2

TOPS	DEPTH	LOG	DATUM	Loc. in Sec.
Anh.				SW SW NE
Tp.				
H.				
Tr.				
Dg.				
Bl.				
L.				Geol. _____
K.C.				Contr. _____
B.K.C.				Co. tools _____
Ce.				Pool _____
C.				Welch-Bornholdt _____
M.				
M.				
K.				
Mz.				
Me.				
V.				
S.				
S.				
A.				
R.				
Pe.				
G.				
T.D.				

Date Comm.

9" @ 150/150 drlg. 1470

12

County Rice Elev. 1549
 Sec. 13 Twp. 20 Rge. 6W
 Company Braden Drilling
 Farm Name Swanson "A" No. 2

TOPS	DEPTH	LOG	DATUM	Loc. in Sec.
Anh.				SW SW NE
Tp.				
H.				
Tr.				
Dg.				
BL.				
L.	2742			Geol.
K.C.				Contr.
B.K.C.				
Ce.				Co. tools
C.	3227			
M.	chert 3264			Pool
M.				Welch-Bornholdt
K.				
Mz.				
Me.				
V.				
S.				
S.				
A.				
R.				
PE.				
G.				
T.D.	3335			COMPLETE

Date Comm.

9" @ 150/150 drlg. 1170 JAN 23 '57

5 1/2 @ 3334/100 JAN 30 '57 FEB 6 '57

PF 16/3268-72 24/3278-84

24/3290-96 FRAC & 40

Boph no/wtr. P. 25

Bopd no/wtr.