

Sec. 13 Twp. 20 R. 2W

Well No. #1 Koehn Farm

P. G. Reynolds et al Company


Wildcat

330 Ft. from N. Line

_____ Ft. from S. Line

_____ Ft. from E. Line

330 Ft. from W. Line

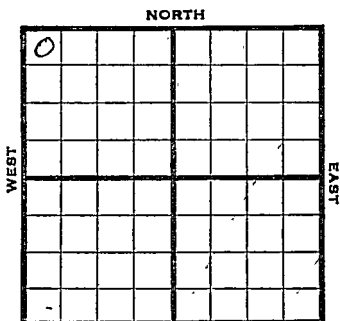

NW/c *Elev. 1539*

1944

R E P O R T

- 10/25 Cellar
- 11/1 "
- 11/8 8" @ 145 WOC
- 11/16 Lans 2228
- Drlg. 2250'
- 11/24 Miss 2927 80 TD run cas.
- 11/29 5" @ 2980 RUST
- 12/6 " " " "
- 12/14 " " " "
- 12/21 " " " "
- 12/29 " " " "
- 1945
- 1/3 " " " "
- 1/10 PB 2973 7 shots 2968-72
- 6 shots 2968-70 300' wtr
- 54 shots 2940-63 S gas
- 1/17 1.4 M gas
- 1/24 Miss. 2927
- 5" @ 2980
- Perf. Miss.
- TD 2980
- 1.4 M Gas

COMPLETED

KANSAS

Pool Name WildcatMap No. 43 Sec. 13 Twp. 20 R. 2WWell No. 1 KoehnP. G. Reynolds et al Company

FIRST REPORT

Contractor

NW/4

SECTION PLAT

330 Ft. from N. Line

_____ Ft. from S. Line

_____ Ft. from E. Line

330 Ft. from W. Line

0			

McPherson

RECORD

Location _____

Cased _____ in., _____ ft.

Rig up _____

Sand _____

Drilling and Remarks:

Gas _____

Cellar

Oil _____

Total Depth _____

PRODUCTION

1st 24 hrs. Nat. _____

1st 24 hrs. after shot _____

Gas _____ Cu. Ft.

Dry Hole _____

Abandoned _____

Date

OCT 25 1944

19

S. J. LEWIS Scout

Pool Name Wildcat

Map No. 42 Sec. 13 Twp. 20 R. 2W

Well No. 1 Koehn


P G Reynolds et al Company

COMPLETED Contractor

NW/c

330 Ft. from N. Line
 _____ Ft. from S. Line
 _____ Ft. from E. Line
330 Ft. from W. Line

SECTION PLAT

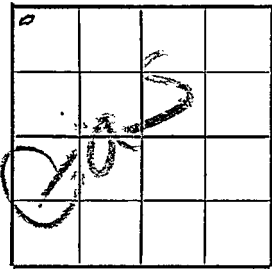

McPherson

Location _____

Rig up _____

Drilling and Remarks:

Miss 2927
5" C 2980
Perf Min
1.4 M Gas

RECORD

Cased _____ in., _____ ft.
 Sand _____
 Gas _____
 Oil _____
 Total Depth 2980

PRODUCTION

1st 24 hrs. Nat. _____
 1st 24 hrs. after shot _____
 Gas _____ Cu. Ft.
 Dry Hole _____
 Abandoned _____

Date

JAN 24 1945 19

S. J. LEWIS Scout