

OILWELL ELEVATIONS AND LOCATIONS

(316) 943-5351

WICHITA, KANSAS 67203

1-8-75

DATE _____

28

20s

14w

NW NW SE

COUNTY

S

T

A

LOCATION

Glen Rupe

OPERATOR

1

Wright

NO

FARM

ELEVATION


1919 Gr.

Mr. Glen N. Rupe

925 Olive Garvey Building

Wichita, Kansas 67202

SCALE: 2" = 1 MILE

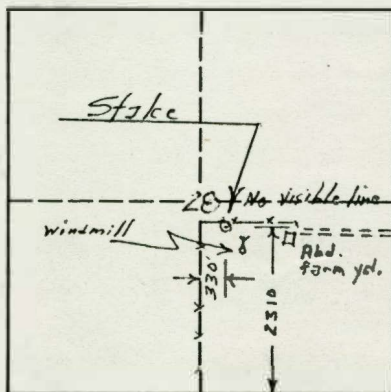

4' iron rod
1' wood stake 9' f/g'g.

10' S of E-W fence
on a ridge & in
a pasture with
cattle

Flagged elect 94

'need no later than Friday' Maxine w/Red Tiger

\$60.00

MINIMUM STAKING CHARGE:
(INCLUDES GROUND ELEVATION)

EXTRA TIME & MILEAGE:**ELEVATION CHARGE:**

TOTAL:

\$60.00

Thank you,
R. E. Glover

L-S ENGINEER

Laughlin-Simmons & Co. of Kansas, Inc. is not liable in case of errors and/or omissions.