


Section 14 Township 20 Range 3W

Well No. #1 Seifried

Company Dunne & Strait

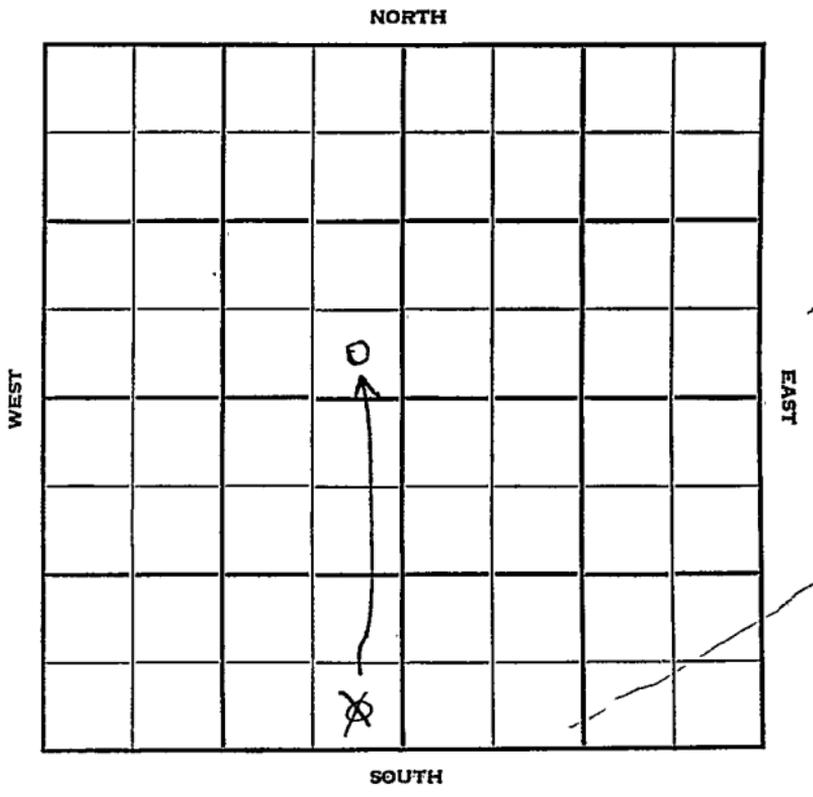

McPherson

KANSAS

Sec. 14 Twp. 20 R. 3 W

Well No. # 1 Seifreid Farm

Dunne & Strait Company

Wildcat Contractor


 Ft. from N. Line

330 Ft. from S. Line

330 Ft. from E. Line

 Ft. from W. Line

~~SE SE SW NW~~
~~SE SE SW NW~~

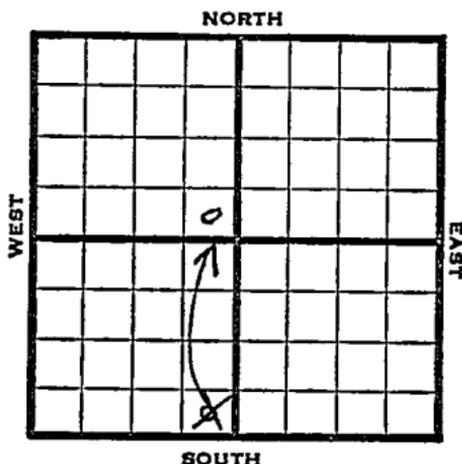

1951

Elev. 1487' REPORT

10/17
11/7

Location

Spud 10-14-51

D&A TD 3057

8" @ 225 Lans. 2394

BKC 2730 Miss 3033

DST 3043-57 opn 1 hr. Rec. 215' sw

TD 3057 D&A

ABANDONED

CORRECTION

Map No. _____ Sec. 14 Twp. 20 R. 3W

Well No. 1 Seifreid

Dunne & Strait

Company

Contractor

SE SE NW

SECTION PLAT

CORRECTION			
o			

_____ Ft. from N. Line

330 Ft. from S. Line

330 Ft. from E. Line

_____ Ft. from W. Line

McPhearson County, Kansas

Location _____

Rig up _____

Drilling and Remarks:

Reported ^{as} SE SE SW

RECORD

Cased _____ in., _____ ft.

Sand _____

Gas _____

Oil _____

Total Depth _____

PRODUCTION

1st 24 hrs. Nat. _____

1st 24 hrs. after shot _____

Gas _____ Cu. Ft.

Dry Hole _____

Abandoned _____

Date

OCT 25 1951

19 _____

Scout

Kansas

Map No. _____ Sec. 14 Twp. 20 R. 3W

Well No. 1 Seifreid

Dunn & Strait

Company

CORRECTION

Contractor

SE SE NW

SECTION PLAT

_____ Ft. from N. Line

330 Ft. from S. Line

330 Ft. from E. Line

_____ Ft. from W. Line

	o		

McPherson County

RECORD

Location _____

Cased _____ in., _____ ft.

Rig up _____

Sand _____

Drilling and Remarks:

Gas _____

Oil _____

Reported

Total Depth _____

~~SE SE SW~~
Was Not!

PRODUCTION

1st 24 hrs. Nat. _____

1st 24 hrs. after shot _____

Gas _____ Cu. Ft.

Dry Hole _____

Abandoned _____

Date

NOV 7 1951 19.

J. E. TYRA

Scout

