

KANSAS


McPherson

FORM 51 5M PETROL

Section 14 Township 20 Range 2W

Well No. 1 Stevenson

Company Huber Oil

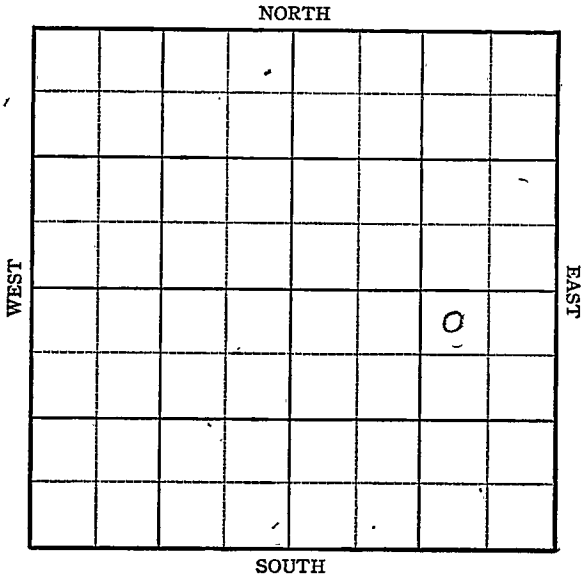

KANSAS

McPherson

Sec. 14 Twp. 20 R. 2-W

Well No. #1 Stevenson Farm


Huber Oil Company

330 Ft. from N. Line

 Ft. from S. Line

990 Ft. from E. Line

 Ft. from W. Line

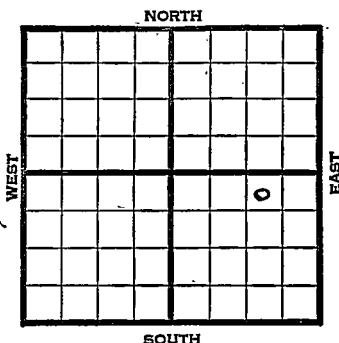

NW NE SE Elev. 1529

1945

REPORT

8/8

8" @ 175'

Drlg. 385'

8/15

Drlg. 2440

8/22

Miss. 2926

TD 2933

5" @ 2928' RUST

8/29

~~1 1/2~~ gas

9/5

Fsg. TD 2933

9/12

Miss. 2926

5" @ 2928

PB 2951

1000 acid.

TD 2968'

1,088,000 Gas

COMPLETED

KANSAS Pool Name WildcatMap No. 43 Sec. 14 Twp. 20 R. 2WWell No. 1 StevensonHuber Oil

Company

FIRST REPORT

Contractor

NW NE SE

SECTION PLAT

330 Ft. from N. Line

Ft. from S. Line

990 Ft. from E. Line

Ft. from W. Line

McPherson County

Location

Rig up

Drilling and Remarks:

8"-175

385

RECORD

Cased _____ in, _____ ft.

Sand

Gas

Oil

Total Depth

PRODUCTION

1st 24 hrs. Nat.

1st 24 hrs. after shot

Gas _____ Cu. Ft.

Dry Hole

Abandoned

Date

AUG 8 1945

19

S. J. LEWIS

Scout

Wildcat

KANSAS

Kansas

Pool Name

Map No.

73

Sec.

14

Twp.

20

R.

2W

Well No.

1 Stevenson

Huber Oil

Company

COMPLETED

Contractor

NW NE SE

E1, 1529

SECTION PLAT

330

Ft. from N. Line

Ft. from S. Line

990

Ft. from E. Line

Ft. from W. Line

			0

McPherson County

Location

Rig up

Drilling and Remarks:

Hus 2926

5' 02928

PB 2931

1000 ac

1, 088, 000 Gas

RECORD

Cased _____ in., _____ ft.

Sand _____

Gas _____

Oil _____

Total Depth 2968

PRODUCTION

1st 24 hrs. Nat. _____

1st 24 hrs. after shot _____

Gas _____ Cu. Ft.

Dry Hole _____

Abandoned _____

Date

SEP 12 1945

19

S. J. LEWIS

Scout