


Section 14 Township 20 Range 8W

Well No. #1 Blevins

Company Allen & Brooks

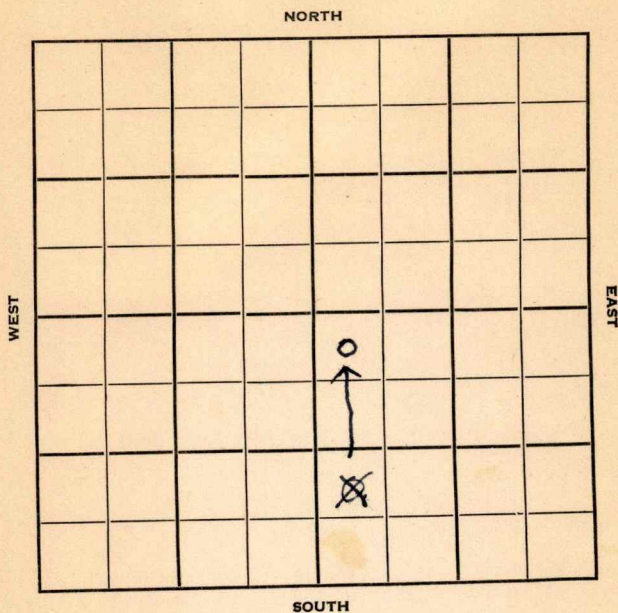

Rice

KANSAS

Sec. 14 Twp. 20 R. 8W

Well No. #1 Blevins Farm


Allen & Brooks Company

330 Ft. from N. Line

990 Ft. from S. Line

_____ Ft. from E. Line

330' Ft. from W. Line

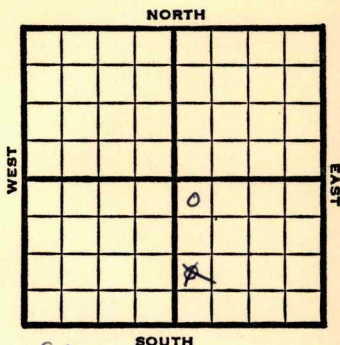

~~NW SW SE~~

NW. NW SE

1950

Elev 1644'

REPORT

1/18

Spud 1-14-50

8" @ 169'

Drlg. 1489'

3/22

8"@ 169'

Cong 3207'

Viola 3361'

5"@ 3336'

TD 3363'

TD 3363

PB 3316'

48 shots 3228-40

SO

Comp 49 BOPD

Comp

COMPLETED

Kansas

Map No. _____ Sec. 14 Twp. 20 R. 8WWell No. 1 BlevinsAllen & Brooks Company

Contractor

NW SW SE

SECTION PLAT

FIRST REPORT			
		0	

_____ Ft. from N. Line

990 Ft. from S. Line

_____ Ft. from E. Line

330 Ft. from W. LineRice County

Location _____

Rig up _____

Drilling and Remarks:

Spud 1-14-50

8" @ 169

drlg. 1489

RECORD

Cased _____ in., _____ ft.

Sand _____

Gas _____

Oil _____

Total Depth _____

PRODUCTION

1st 24 hrs. Nat. _____

1st 24 hrs. after shot _____

Gas _____ Cu. Ft.

Dry Hole _____

Abandoned _____

Date

JAN 18 1950 19J. E. TYRA Scout

Kansas

Map No. _____ Sec. 14 Twp. 20 R. 8WWell No. 1 Blevins

_____ Allen & Brooks _____ Company

CORRECTION

_____ Contractor

NW NW SE

El. 1644

SECTION PLAT

		o	

330 Ft. from N. Line

_____ Ft. from S. Line

_____ Ft. from E. Line

330 Ft. from W. LineRice County

Location _____

Rig up _____

Drilling and Remarks:

Reported

NW SW SE

RECORD

Cased _____ in., _____ ft.

Sand _____

Gas _____

Oil _____

Total Depth _____

PRODUCTION

1st 24 hrs. Nat. _____

1st 24 hrs. after shot _____

Gas _____ Cu. Ft.

Dry Hole _____

Abandoned _____

Date

JAN 25 1950 19J. E. TYRA

Scout

Map No. _____ Sec. 14 Twp. 20 R. 8WWell No. 1 BlevinsAllen & Brooks

Company

Contractor

NW NW SE


E1. 1644

SECTION PLAT

330 Ft. from N. Line

_____ Ft. from S. Line

_____ Ft. from E. Line

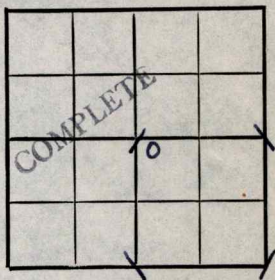330 Ft. from W. LineRice County

Location _____

Rig up _____

Drilling and Remarks:

8" @ 169Cong. 3207Viola 33615" @ 3336TD. 3363P.B. 331648 shots 3228-4050Comp. 49 logs

Date

RECORD

Cased _____ in., _____ ft.

Sand _____

Gas _____

Oil _____

Total Depth _____

PRODUCTION

1st 24 hrs. Nat. _____

1st 24 hrs. after shot _____

Gas _____ Cu. Ft.

Dry Hole _____

Abandoned _____

MAR 22 1950 19J. E. TYRA Scout