
FORM 51 25M 3-49 PETROL Rice KANSAS

Section 14 Township 20 Range 8 W

Well No. # 2 Blevins

Company Tom Allan et al

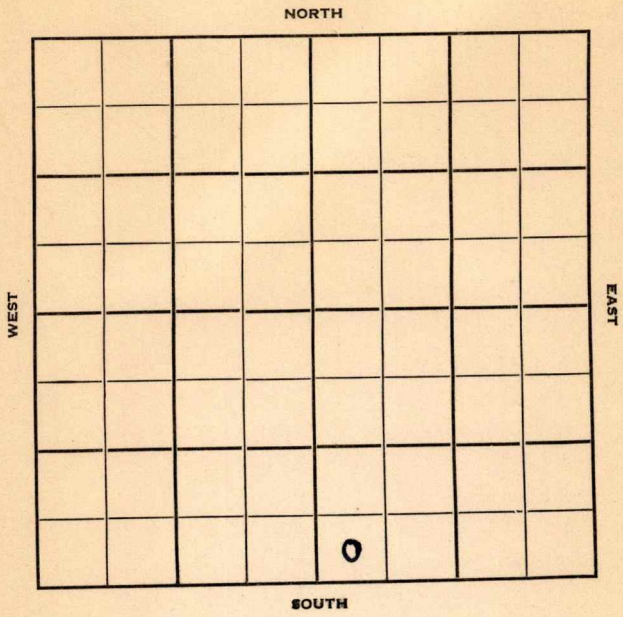

FORM 252-B
10M 8-51 TPCO.

KANSAS

Rice

Sec. 14 Twp. 20 R. 8W

Well No. #2 Blevins Farm

Tom Allan et al Company

Contractor


Ft. from N. Line

330' Ft. from S. Line

Ft. from E. Line

330' Ft. from W. Line

SW SW SE

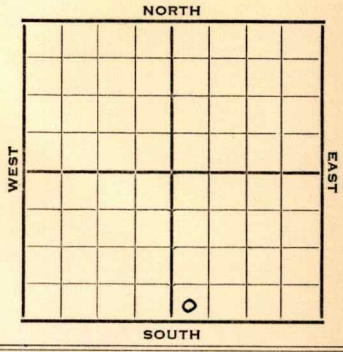

1952	Elev - REPORT
4/23	MIR
4/30	8" @ 174' Drlg. 2590'
5/7	Spud 4-21-52 D&A TD 3273 8" @ 174 Lans. 2860 Cong. 3245 Kh 3258 DST 3217-72 opn 40 min. Rec. 15'mud TD 3273 D&A ABANDONED

FORM 275 FOR SALE BY KANSAS BLUE PRINT CO.


County Rice State Kansas

Sec. 14 (Blk. Twp.) 20 (Sur. Rge.) 8W Map No.

Operator Tom Allan etal.

Well No. 2 Farm Blevins

Elev. Location SW SW SE

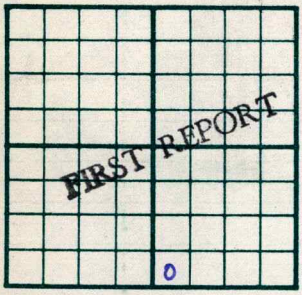

330 Ft. From S Line SE

330 Ft. From W Line Quarter

1st. Report APR 23 1952

Completion

Remarks

Spudding Date

Drlg. Data

M I R

J. G. McGEHEE

FORM 275 FOR SALE BY KANSAS BLUE PRINT CO.

County Rice State Kansas

Sec. 14 (Blk. Twp.) 20 (Sur. Rge.) 8W Map No.

Operator Tom Allan etal.

Well No. 2 Farm Blevins

Elev. Location SW SW SE



330 Ft. From S Line SE

330 Ft. From W Line Quarter

1st. Report

Completion MAY 7 1952

Remarks

Spudding Date 4-21-52

Drlg. Data D & A TD 3273

8" @ 174 Lans. 2860 Cong. 3245

Kh. 3258 DST 3217-72 open 40 min.

Rec. 15' mud TD 3273

D & A

J. G. McGEHEE