


Section 14 Township 20 Range 8W

Well No. #3 Stahl

Company Tom Allan et al

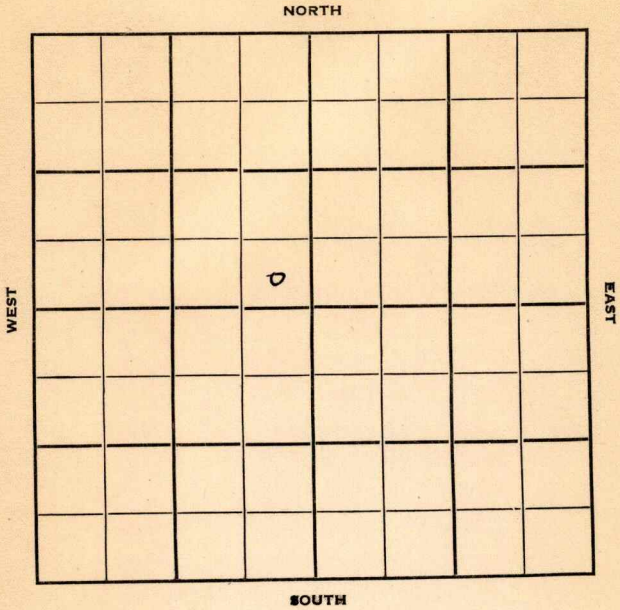

Rice

KANSAS

Sec. 14 Twp. 20 R. 8W ✓

Well No. #3 Stahl Farm

Tom Allen et al Company

Allen Contractor

Lyons Pool


Ft. from N. Line

330' Ft. from S. Line

330' Ft. from E. Line

Ft. from W. Line

SE NW

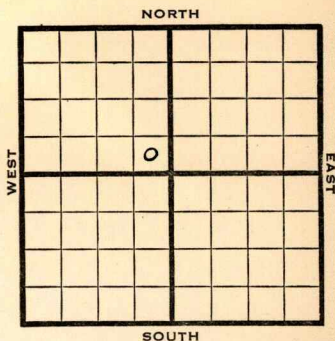

1949

^u lev 1644'

REPORT

11/2

8" @ 170'
Drlg. 1850'

11/9

Drlg. 3063'

11/16

Misener 3298'

TD 3301

5"@ 3301'

11/23

"

11/29

Misener 3296'

5"@ 3297'

TD 3304

Flow 50 bbls oil 24 hrs

12/7

TD 3304'

Misener 3296'

5"@ 3297'

Flow 109 Oil Pot

41° Gr.

Comp

COMPLETED

Kansas

Lyons Pool

Map No. _____ Sec. 14 Twp. 20 R. 8WWell No. 3 Stahl_____
Tom Allan et al. _____ Company_____
Allan _____ Contractor

SE NW

FIRST REPORT
SECTION PLAT

Ft. from N. Line330 Ft. from S. Line330 Ft. from E. Line_____
Ft. from W. Line

Rice County

Location _____

Rig up _____

Drilling and Remarks:

8" @ 170

drlg. 1850

RECORD

Cased _____ in., _____ ft.

Sand _____

Gas _____

Oil _____

Total Depth _____

PRODUCTION

1st 24 hrs. Nat. _____

1st 24 hrs. after shot _____

Gas _____ Cu. Ft.

Dry Hole _____

Abandoned _____

Date

NOV 2 1949

19

S. J. LEWIS

Scout

Kansas

Map No. _____ Sec. 14 Twp. 20 R. 8WWell No. 3 Stahl

Tom Allan et al. _____ Company

COMPLETE

Contractor


SE NW

E11644
SECTION PLAT

_____ Ft. from N. Line

330 Ft. from S. Line330 Ft. from E. Line

_____ Ft. from W. Line

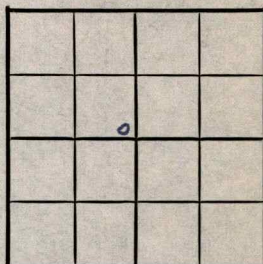

Rice County

Location _____

Rig up _____

Drilling and Remarks:

*Murine 3296**5" C3292**Flow 109 oil**H/O*

RECORD

Cased _____ in., _____ ft.

Sand _____

Gas _____

Oil _____

Total Depth 3804

PRODUCTION

1st 24 hrs. Nat. _____

1st 24 hrs. after shot _____

Gas _____ Cu. Ft.

Dry Hole _____

Abandoned _____

Date

DEC 7 1949

19

S. J. LEWIS

Scout