FORM 51 10M 2-49 PETROL

KANSAS


Rice

Section 14 Township 20 Range SW

Well No. 1 Williams

Company Tom Allan et al

Lyons

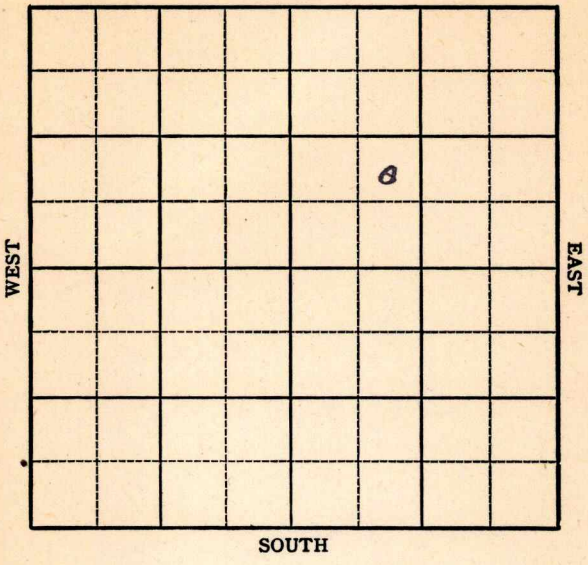

FORM 252-A
5M 10-48 PETROL


Rice KANSAS
14 20 8W

Sec. 14 Twp. 20 R. 8W

Well No. #1 Williams Farm

Tom Allen et al Company

Lyons Pool (Tom Allen, Cont.)

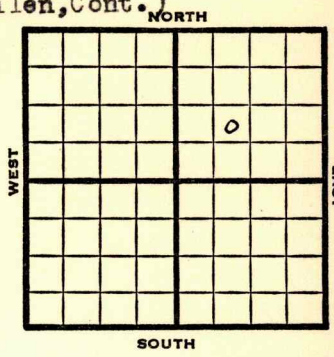

990' Ft. from N. Line

990' Ft. from S. Line

Ft. from E. Line

990' Ft. from W. Line

NE SW NE

1949	REPORT
	Elev 1648'
9/7	8" @ 149'
9/14	Drlg 2494'
9/21	Misner 3302' TD 3306' 5" @3305'
9/28	TD 3316' Misener 3302' 5"@ 3305' Aband. ABANDONED

3302
1648
1654

26 200 Bks. 6-49 Petrol

Kansas

Lyons Pool

Map No. Sec. 14 Twp. 20 R. 8W

Well No. 1 Williams


Tom Allan etal. Company

Tom Allan Contractor

NE SW NE

FIRST REPORT

SECTION PLAT

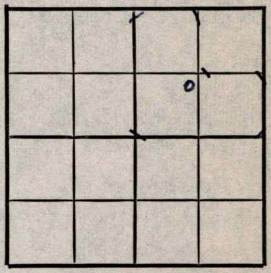

Ft. from N. Line

990 Ft. from S. Line

Ft. from E. Line

990 Ft. from W. Line

Rice County

Location

Rig up

Drilling and Remarks:

8" @ 149

RECORD

Cased in., ft.

Sand

Gas

Oil

Total Depth

PRODUCTION

1st 24 hrs. Nat.

1st 24 hrs. after shot

Gas Cu. Ft.

Dry Hole

Abandoned

Date

SEP 7 1949 19 S. J. LEWIS Scout

Form 26 200 Bks. 6-49 Petrol

Lyons Pool

Kansas

Map No. _____ Sec. 14 Twp. 20 R. 8W

Well No. 1 Williams


Tom Allan etal. Company

ABANDONED Contractor

NE SW NE

E. 1648'

SECTION PLAT

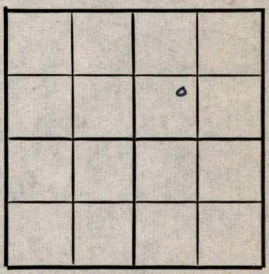

_____ Ft. from N. Line

990 Ft. from S. Line

_____ Ft. from E. Line

990 Ft. from W. Line

Rice County

Location _____

Rig up _____

Drilling and Remarks:

Miss. @ 3302

5" @ 3304

RECORD

Cased _____ in., _____ ft.

Sand _____

Gas _____

Oil _____

Total Depth 3316.

PRODUCTION

1st 24 hrs. Nat. _____

1st 24 hrs. after shot _____

Gas _____ Cu. Ft.

Dry Hole _____

Abandoned _____

Date

SEP 28 1949 19

S. J. LEWIS Scout