


STATE OF KANSAS
STATE CORPORATION COMMISSION

Give All Information Completely
Make Required Affidavit
Mail or Deliver Report to:
Conservation Division
State Corporation Commission
211 No. Broadway
Wichita, Kansas

WELL PLUGGING RECORD

NORTH

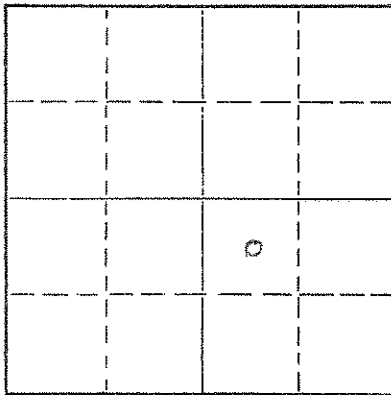

Locate well correctly on above Section Plat

Barton County. Sec. 22 Twp. 20 Rge. (E) 15 (W)
Location as "NE/CNWxSWx" or footage from lines 660^s & 660^E of Center
Lease Owner Office Service Oil Co.
Lease Name Bowman Well No. 1
Office Address Bv, Okla
Character of Well (completed as Oil, Gas or Dry Hole) Gas
Date well completed Febr. 25th 19 48
Application for plugging filed May 18th 19 50
Application for plugging approved May 17th 19 50
Plugging commenced May 31st 19 50
Plugging completed June 6th 19 50
Reason for abandonment of well or producing formation Depleted Production

If a producing well is abandoned, date of last production February 19 49
Was permission obtained from the Conservation Division or its agents before plugging was commenced? Yes

Name of Conservation Agent who supervised plugging of this well C. V. Staugh
Producing formation Albuckle Depth to top 3651 Bottom 3750 Total Depth of Well 3750 Feet
Show depth and thickness of all water, oil and gas formations. P.B. T.D. 3695'

OIL, GAS OR WATER RECORDS

CASING RECORD

FORMATION	CONTENT	FROM	TO	SIZE	PUT IN	PULLED OUT
				<u>8 1/2"</u>	<u>940</u>	<u>0</u>
				<u>5 1/2"</u>	<u>3750</u>	<u>2028'</u>

Describe in detail the manner in which the well was plugged, indicating where the mud fluid was placed and the method or methods used in introducing it into the hole. If cement or other plugs were used, state the character of same and depth placed, from _____ feet to _____ feet for each plug set.

3695' to 3645' Sand
3645' to 260' 5' sx cement & mud
260' to 250' bridge & rock
250' to 30' 10' sx cement & mud
30' to base of cellar 10' sx of cement

(If additional description is necessary, use BACK of this sheet)

Name of Plugging Contractor C. E. Shull Co. Plugging Co.
Address Great Bend, Kansas

STATE OF _____, COUNTY OF _____, ss.

(employee of owner) or (owner or operator) of the above-described well, being first duly sworn on oath, says: That I have knowledge of the facts, statements, and matters herein contained and the log of the above-described well as filed and that the same are true and correct. So help me God.

(Signature) _____

(Address) _____

SUBSCRIBED AND SWORN TO before me this _____ day of _____, 19 _____

My commission expires _____

Notary Public.

