


Section 15 Township 20 Range 3W

Well No. #1 Sinden

Company Lotus Oil
Wildcat

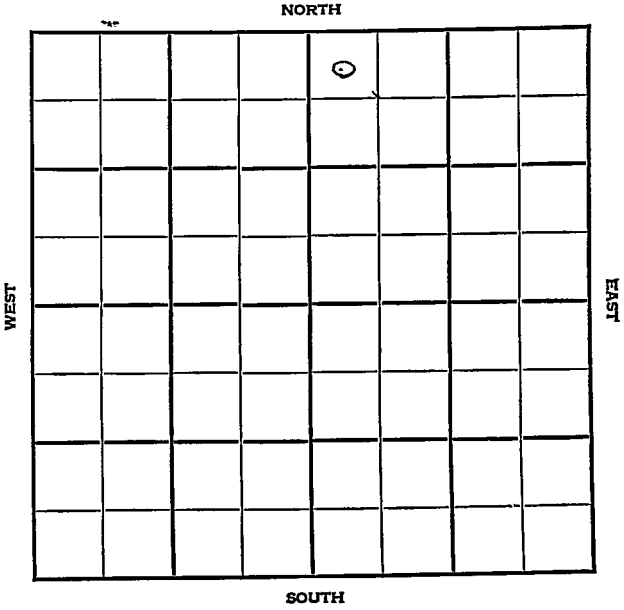

KANSAS

McPherson County



Sec. 15 Twp. 20 R. 3W

Well No. #1 Sinden Farm

Lotus Oil Company


Wildcat

330 Ft. from N. Line

_____ Ft. from S. Line

_____ Ft. from E. Line

330 Ft. from W. Line

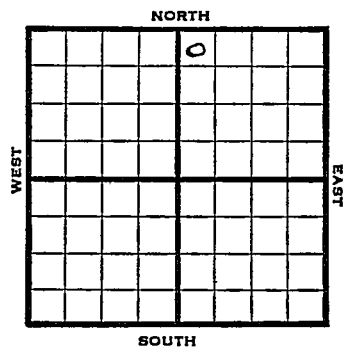

NW NE

1948 Elev. - REPORT

4/21	8" @ 158' Drlg. 2765'
4/28	Mississippi 3026' TD 3035' 5" @ 3027' RUST
5/5	Miss 3026' 5" @ 3027' TD 3092' ABANDONED

Map No. _____ Sec. 15 Twp. 20 R. 3W

Well No. 1 Sinden

Lotus Oil Company

FIRST REPORT

Contractor _____

NW NE

SECTION PLAT

330 Ft. from N. Line

_____ Ft. from S. Line

_____ Ft. from E. Line

330 Ft. from W. Line

		o	
			/

McPherson County

Location _____

Rig up _____

Drilling and Remarks:

8" @ 158.

drlg. 2765

RECORD

Cased _____ in., _____ ft.

Sand _____

Gas _____

Oil _____

Total Depth _____

PRODUCTION

1st 24 hrs. Nat. _____

1st 24 hrs. after shot _____

Gas _____ Cu. Ft.

Dry Hole _____

Abandoned _____

Date

APR 21 1948

19

S. I. LEWIS Scout

Map No. 43 Sec. 15 Twp. 20 R. 3W

Well No. 1 Sinden

Lotus Oil Company

ABANDONED Contractor

NW NE

SECTION PLAT

330 Ft. from N. Line

_____ Ft. from S. Line

_____ Ft. from E. Line

330 Ft. from W. Line

		0	

McPherson County

Location _____

Rig up _____

Drilling and Remarks:

*Miss 3026
5' C 3027*

RECORD

Cased _____ in., _____ ft.

Sand _____

Gas _____

Oil _____

Total Depth 3092

PRODUCTION

1st 24 hrs. Nat. _____

1st 24 hrs. after shot _____

Gas _____ Cu. Ft.

Dry Hole _____

Abandoned _____

Date

MAY 5 1948 19 S. J. LEWIS Scout