

KANSAS

Form 51-5M-7-39-Palace

Rice

Section 15 Township 20 Range 6-W

Well No. #1 Conrad


Company C. L. Carlock et al

Wildcat

NORTH

WEST

EAST

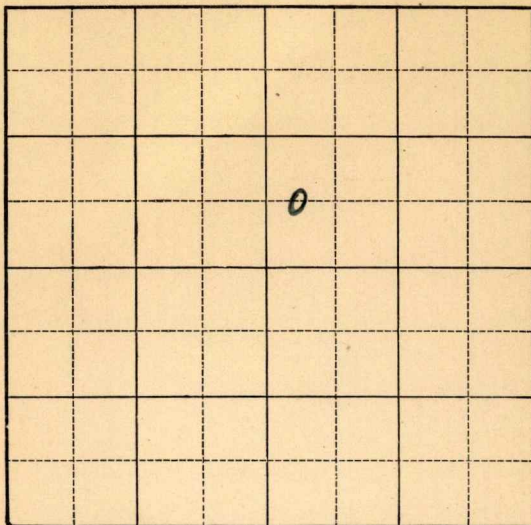

SOUTH

Map No. 48 Sec. 15 Twp. 20 R. 6WWell No. 1 ConradC.L. Carlock et al

Company

Contractor

FIRST REPORT

C W L SW NE

Ft. from N. Line

660 Ft. from S. Line

Ft. from E. Line

330 Ft. from W. Line

WILDCAT

SECTION PLAT

		o	

Location _____

Rig up _____

Drilling and Remarks:

Rigging up Rotary

RECORD

Cased _____ in., _____ ft.

Sand _____

Gas _____

Oil _____

Total Depth _____

PRODUCTION

1st 24 hrs. Nat. _____

1st 24 hrs. after shot _____

Gas _____ Cu. Ft.

Dry Hole _____

Abandoned _____

Date

MAY 8 1940S. J. LEWIS Scout

Map No. 48 Sec. 15 Twp. 20 R. 6WWell No. 1 ConradC. L. Carlock et al Company

Contractor

ABANDONED

C W L SW NE

 Ft. from N. Line660 Ft. from S. Line Ft. from E. Line330 Ft. from W. Line

WILDCAT

SECTION PLAT

		0	

Location Rig up

Drilling and Remarks:

*Ok @ 3308.**7" @ 3308.**No show.*

RECORD

Cased in., ft.Sand Gas Oil Total Depth 3390

PRODUCTION

1st 24 hrs. Nat. 1st 24 hrs. after shot Gas Cu. Ft.Dry Hole Abandoned

Date

JUN 12 1940

19

S. J. LEWIS

Scout