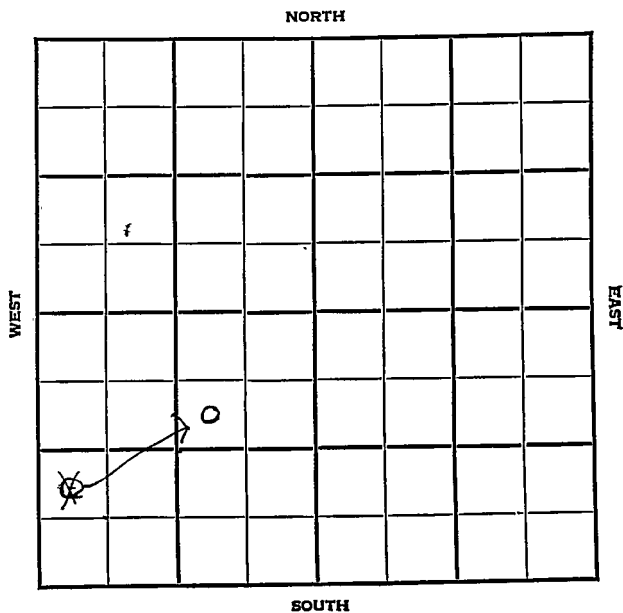


Kanons

Rice

Section 15 Township 20 Range 9NWell No. #3 DickCompany Lindas Oil

~~HOT FILE~~
KANSAS

Rice

Sec. 15 Twp. 20 R. 9W ✓

Well No. #3 Dick Farm

Lindas Oil Company

Chase Pool

990 Ft. from N. Line


990+ Ft. from S. Line

990 Ft. from E. Line

330+ Ft. from W. Line

~~NW SW SW~~

SW NE SW

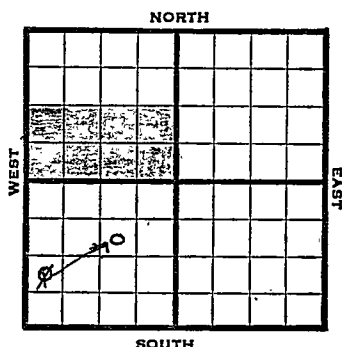

1948

Elev. 1705' REPORT

2/4

8" @ 111'

Any. 280'

Drlg. 1210'

2/11

Drlg. 2780'

2/18

No Report

2/25

"

3/3

Lansing 2886'

Arbuckle 3222'

TD 3224'

5" @ 3222'

RUST

3/10

"

3/17

"

3/24

"

3/31

Arbuckle 3222'

5" @ 3222'

Pump 125 Pot.

Gr. 42.7°

TD 3224'

COMPLETED

Map No. _____ Sec. 15 Twp. 20 R. 9W

Well No. 3. Dick

Lindas Oil

Company

FIRST REPORT

Contractor

NW SW SW


SECTION PLAT

_____ Ft. from N. Line

990 Ft. from S. Line

_____ Ft. from E. Line

330 Ft. from W. Line

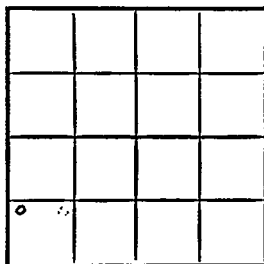

Rice County

Location _____

Rig up _____

Drilling and Remarks:

8" @ 111

Anhy 280

drlg. 1210

RECORD

Cased _____ in., _____ ft.

Sand _____

Gas _____

Oil _____

Total Depth _____

PRODUCTION

1st 24 hrs. Nat. _____

1st 24 hrs. after shot _____

Gas _____ Cu. Ft.

Dry Hole _____

Abandoned _____

Date

FEB 4 1948 19

S. J. LEWIS

Scout

Map No. 49 Sec. 15 Twp. 20 R. 9W

Well No. 3 Dick

Lindas Oil Company

CORRECTION Contractor

SW NE SW

990 Ft. from N. Line

 Ft. from S. Line

990 Ft. from E. Line

 Ft. from W. Line

Rice County

SECTION PLAT

Location

Rig up

Drilling and Remarks:

Reported

NW SW SW

RECORD

Cased in., ft.

Sand

Gas

Oil

Total Depth

PRODUCTION

1st 24 hrs. Nat.

1st 24 hrs. after shot

Gas Cu. Ft.

Dry Hole

Abandoned

Date

FEB 11 1948 19

S. J. LEWIS Scout

Map No. 49 Sec. 15 Twp. 20 R. 9W

Well No. 3 Dick

Lindas Oil Company

COMPLETE

Contractor

SW NE SW


E11705
SECTION PLAT

990 Ft. from N. Line

Ft. from S. Line

990 Ft. from E. Line

Ft. from W. Line

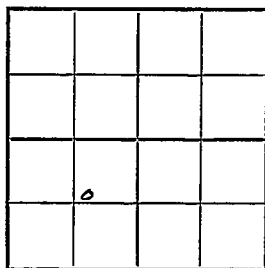

Rice County

Location

Rig up

Drilling and Remarks:

Per 83222.

5" 83222.

Pump 12588

42 3/4

RECORD

Cased in., ft.

Sand

Gas

Oil ☒

Total Depth 8224

PRODUCTION

1st 24 hrs. Nat.

1st 24 hrs. after shot

Gas Cu. Ft.

Dry Hole

Abandoned

Date

MAR 31 1948

19

S. J. LEWIS

Scout