


Map No. **KANSAS** Sec. 15 Twp. 20 R. Rice 9W

Well No. 3-1 Hartle Farm _____
Haynes Oil Company _____

NORTH

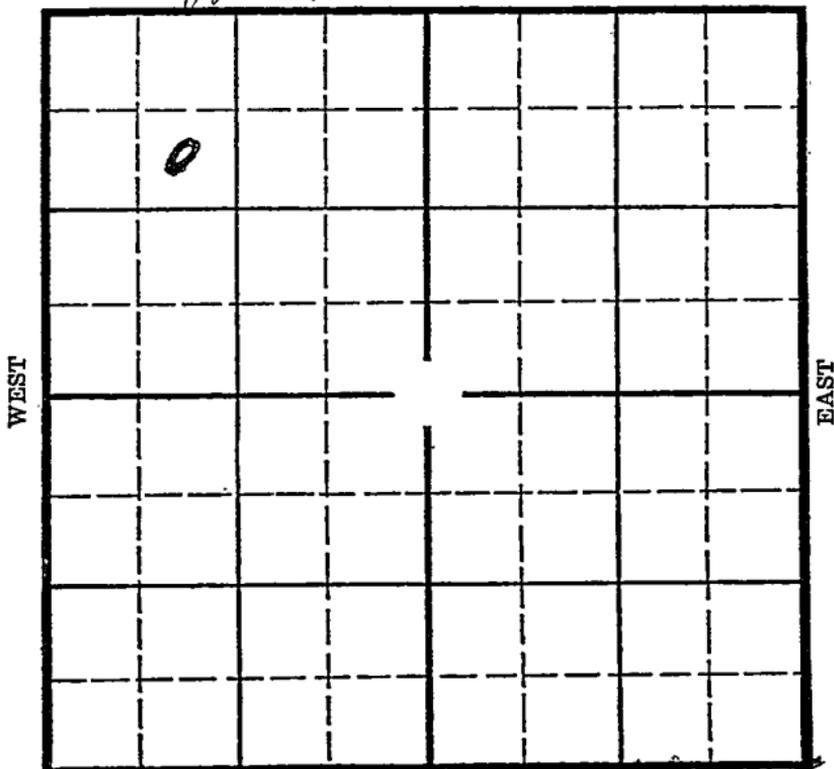

SOUTH

Offset

Location _____

Drilling Remarks _____

Rig Up _____

Drilling Remarks _____

RECORD

Cased _____ in. _____ ft.

Sand _____

Gas _____

Oil _____

Total Depth _____

PRODUCTION

1st 24 hrs. Nat. _____

1st 24 hrs. after shot _____

Gas _____ cu. ft. _____

Dry Hole _____


Abandoned _____

Rice
9th

Map No. KANSAS Sec. 15 Twp. 20 R. 9th

Well No. 3- Bartle Farm
Pepper Oil Company

990 Ft. from N. Line
 Ft. from S. Line
 Ft. from E. Line
990 Ft. from W. Line

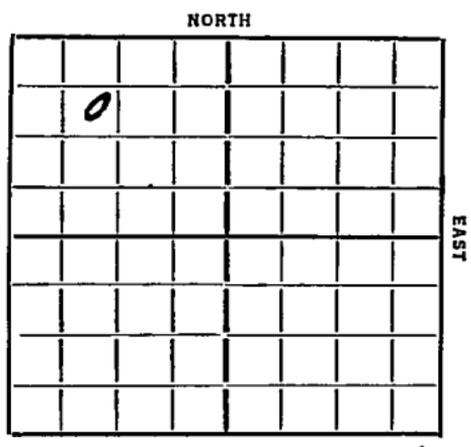

Elev. 1708

REPORT OFFSET

Date

1935
10/30 B.R.
11/7 —
11/14 log 28 73
11/21 lib 3211-17 7" 3216 Reel
11/29 20 3219 TD 3223
 2500' OTH @ Savings run
12/6 TD 3289
 Swabbed 256 Hbls Taking pot
12/13 TD 3240 P. 818 lib
 1000 acid w.o.A.
12/18 lib 3211
 TD 3239
 818 Hbls Net
 1000 acid
 882 Hbls.

COMPLETED

Map No. 49 Sec. 15 Twp. 20 R. 9W

Well No. 3-Hartle

Kysey Oil Company

Contractor

SECTION PLAT

FIRST REPORT

990 Ft. from N. Line

..... Ft. from S. Line

..... Ft. from E. Line

990 Ft. from W. Line

offset

Location.....

Rig up.....

Drilling and Remarks:

B.R.

RECORD

Cased..... in., ft.

Sand.....

Gas.....

Oil.....

Total Depth.....

PRODUCTION

1st 24 hrs. Nat.....

1st 24 hrs. after shot.....

Gas..... Cu. Ft.

Dry Hole.....

Abandoned.....

Date

10-30-35 192

ORVAL MANNING-RECK

Scout

Map No. 49 Sec. 15 Twp. 20 R. 9W

Well No. 3-Hartle

Gypsy oil

Company

Contractor

ABANDONED

SECTION PLAT

990 Ft. from N. Line

..... Ft. from S. Line

..... Ft. from E. Line

990 Ft. from W. Line

0			

offset

Location.....

Rig up.....

Drilling and Remarks:

818 bbls natural
1000 acid
882 bbls

RECORD

Cased..... in., ft.

Sand Sil 3211

Gas.....

Oil.....

Total Depth 3239

PRODUCTION

1st 24 hrs. Nat.....

1st 24 hrs. after shot.....

Gas..... Cu. Ft.

Dry Hole.....

Abandoned.....

Date

12-18-35

192.....

Scout

KANRECHECK