


Section 15 Township 20 Range 9-W

Well Number #4-Dick

Company Gulf

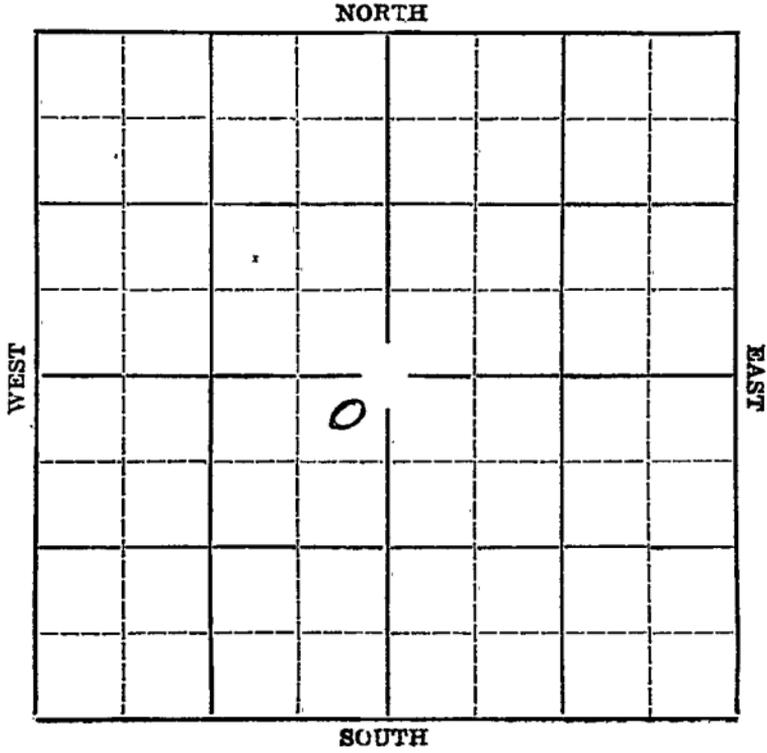

Map No. 49 Sec. 15 Twp. 20 R. 9W

Well No. 4 Dick

Gulf Company

Contractor

SECTION PLAT

330 Ft. from N. Line

_____ Ft. from S. Line

330 Ft. from E. Line

330 Ft. from W. Line

	0		

TEST REPORT

Location _____

Rig up _____

Drilling and Remarks:

Rig

RECORD

Cased _____ in., _____ ft.

Sand _____

Gas _____

Oil _____

Total Depth _____

PRODUCTION

1st 24 hrs. Nat. _____

1st 24 hrs. after shot _____

Gas _____ Cu. Ft.

Dry Hole _____

Abandoned _____

Date

JUN 24 1936

19

S. J. LEWIS Scout

Map No. 49 Sec. 15 Twp. 20 R. 9W

Well No. 4 Dick

Gulf. Company
Contractor

SECTION PLAT

	0		

280 Ft. from N. Line

_____ Ft. from S. Line

330 Ft. from E. Line

_____ Ft. from W. Line

Oil well

Location _____

Rig up _____

Drilling and Remarks:

Oil 3220
P.B 3232.
Pay 415 yds.
Nat.

RECORD

Cased _____ in., _____ ft.

Sand _____

Gas _____

Oil _____

Total Depth 3232 1/2

PRODUCTION

1st 24 hrs. Nat. _____

1st 24 hrs. after shot _____

Gas _____ Cu. Ft.

Dry Hole _____

Abandoned _____

Date

AUG 5 1936 19

S. J. LEWIS Scout