


RICE

Form 51-5M-3-35-Mid-West

Map No. KANSAS Sec. 15 Twp. 20 R. 9WWell No. #5 Hartle Farm
Gulf. Company

NORTH

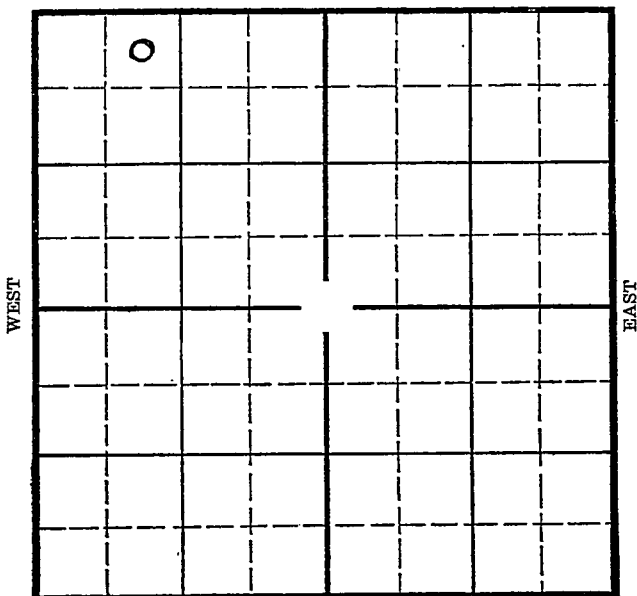

SOUTH

Location _____

Drilling Remarks _____

Rig Up _____

Drilling Remarks _____

RECORD

Cased _____ in. _____ ft.

Sand _____

Gas _____

Oil _____

Total Depth _____

PRODUCTION

1st 24 hrs. Nat. _____

1st 24 hrs. after shot _____

Gas _____ cu. ft. _____

Dry Hole _____

Abandoned _____


Map No. _____ Sec. 15 Twp. 20 R. 9-WWell No. 5-Hartle Farm _____
Gulf Company _____330 Ft. from N. Line

_____ Ft. from S. Line

_____ Ft. from E. Line

990 Ft. from W. Line

Elev. 1708

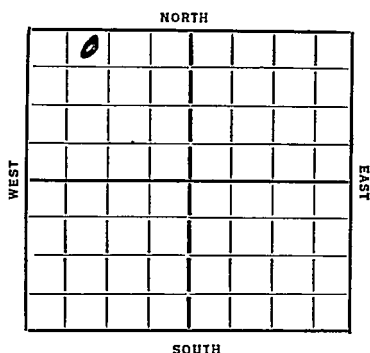Date
1936

REPORT

4/8 Rig

4/16 Drlg. 1719'

4/23 Drlg. 2910'

4/30 Sil. 3226 $\frac{1}{2}$ '. T.D. 3235 $\frac{1}{2}$ '.

5/7 1500' acid. Pump 211 bbls in 11 hrs

5/13/36-Sil. 3226 $\frac{1}{2}$ '.T.D. 3235 $\frac{1}{2}$ '.

1500 acid.

453 bbls.

COMPLETED

Map No. 49 Sec. 15 Twp. 20 R. 9NWell No. 5, HartteGaly. Company

Contractor

SECTION PLAT

320 Ft. from N. Line

Ft. from S. Line

Ft. from E. Line

990 Ft. from W. Line

0			

FIRST REPORT

Location.....

Rig up.....

Drilling and Remarks:

1 1/2

RECORD

Cased.....in., ...ft.

Sand.....

Gas.....

Oil.....

Total Depth.....

PRODUCTION

1st 24 hrs. Nat.....

1st 24 hrs. after shot.....

Gas.....Cu. Ft.

Dry Hole.....

Abandoned.....

Date

4/8/36 192

S. J. LEWIS

Scout

KANSAS

Map No. 49 Sec. 15 Twp. 20 R. 9 WWell No. 5 Hartte

Company

Contractor

SECTION PLAT

0			
-			

320 Ft. from N. Line

_____ Ft. from S. Line

_____ Ft. from E. Line

990 Ft. from W. Line

COMPLETED

Location _____

Rig up _____

Drilling and Remarks:

Bit 322 1/21500 acid453 8 1/2

RECORD

Cased _____ in., _____ ft.

Sand _____

Gas _____

Oil _____

Total Depth 3235 1/2

PRODUCTION

1st 24 hrs. Nat. _____

1st 24 hrs. after shot _____

Gas _____ Cu. Ft.

Dry Hole _____

Abandoned _____

Date

MAY 13 1936

19

S. J. LEWIS

Scout