


Well No. 1-102 John Farm

NORTH

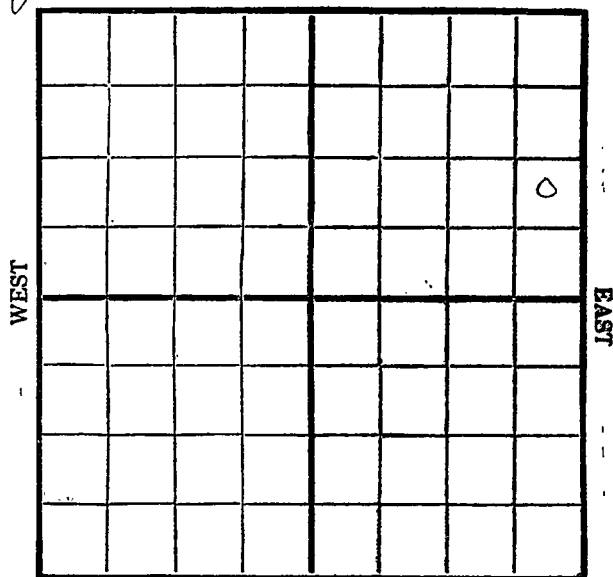

SOUTH

Drilling Remarks

Drilling Remarks

RECORD

Total Depth_____

PRODUCTION

Abandoned _____


Map No. KANSAS Sec. 15 Twp. 20 R. 2^w
Well No. 1- Toehms Farm
Reynolds et al Company

 Ft. from N. Line

990 Ft. from S. Line

330 Ft. from E. Line

 Ft. from W. Line

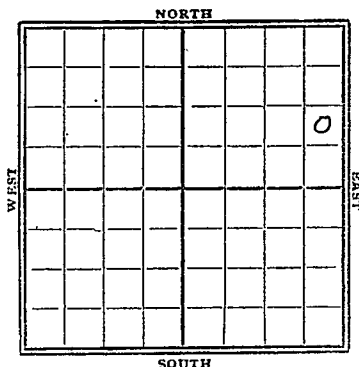

1929

Date

REPORT

9/11	Timbers
9/18	Rig
9/24	
10/2	
10/9	
10/16	
10/23	Spud
10/30	Drly 1085'
11/6	Run 12"- 1470'
11/13	Drly 2000'
11/20	Run 10"- 2272
11/27	Run 8"- 2434
12/4	Drly 2670
12/11	Top Chat 2970
	show gas 2972
	HFW 2985-90
	Drly 3002
12/18	" 3200'
12/23	Base Miss line 3220
	Drly 3355'
12/30	Top Milcox 3443'
	HFW 3447 Drly 3450'

1930

- 1/8- Fsg tools 3450'
 - 1/15- UPR 5"- 3450'
 - 1/22- Wilcox 3440-50'
- T.D. 3500' HFW
Dry & Abandon

Map No. KANSAS Sec. 15 Twp. 20 R. 24

Well No. 43 110 E. line

Reynolds & Dal Company

Contractor

SECTION PLAT

.....Ft. from N. Line

990 Ft. from S. Line

380 Ft. from E. Line

.....Ft. from W. Line

			0

FIRST REPORTS

Location.....

Rig up.....

Drilling and Remarks:

Timber

RECORD

Cased.....in.,ft.

Sand.....

Gas.....

Oil.....

Total Depth.....

PRODUCTION

1st 24 hrs. Nat.....

1st 24 hrs. after shot.....

Gas.....Cu. Ft.

Dry Hole.....

Abandoned.....

Date

SEP 11 1929

.....192.....

S. J. LEWIS Scout

Map No. KANSAS Sec. 15 Twp. 20 R. 2W

Well No. 43 1 Koe hn

Reynolds & Co Company

Contractor

SECTION PLAT

..... Ft. from N. Line

990 Ft. from S. Line

830 Ft. from E. Line

..... Ft. from W. Line

			0

ABANDONED

Location.....

Rig up.....

Drilling and Remarks:

No top 3440-50
HPW.

RECORD

Cased..... in., ft.

Sand.....

Gas.....

Oil.....

Total Depth 3500

PRODUCTION

1st 24 hrs. Nat.....

1st 24 hrs. after shot.....

Gas..... Cu. Ft.

Dry Hole.....

Abandoned.....

Date

JAN 22 1932

S. J. LEWIS

Scout