

Rice


FORM 51 IOM 12-46 PETROL

KANSAS

Section 15 Township 20 Range 8W

Well No. 1 Hutchins

Company Helmerich & Payne

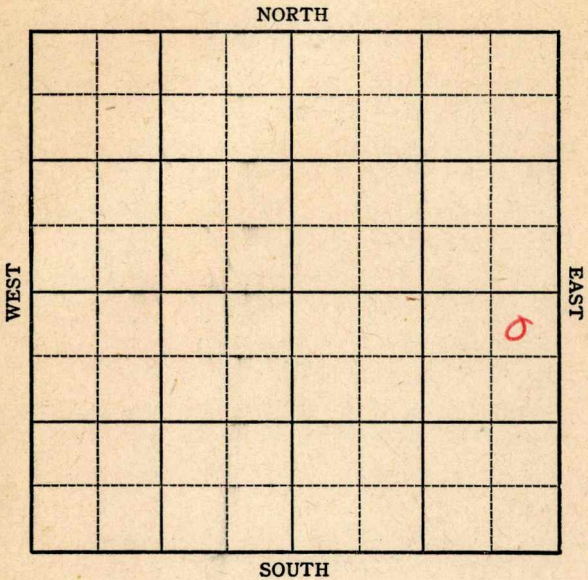

KANSAS

Rice

Sec. 15 Twp. 20 R. 8-W

Well No. #1 Hutchins Farm

Helmerich & Payne Company

Wildcat


330 Ft. from N. Line

         Ft. from S. Line

330 Ft. from E. Line

         Ft. from W. Line

NE SE

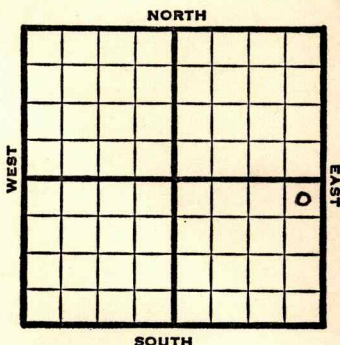

1947 **Elev. 1644'** REPORT

6/11 Location

6/17 10" @ 310'  
Drlg. 2075'

6/24 Drlg. 3431'

7/2 **Lans. 2830'**  
**Cong. 3230'**  
**Arb. 3501'**  
TD 3526'

3230  
1674  

---

1586

**ABANDONED**

Map No. \_\_\_\_\_ Sec. 15 Twp. 20 R. 8W

Well No. 1 Hutchins

Helmerich & Payne Company

FIRST REPORT Contractor

NE SE


SECTION PLAT

330 Ft. from N. Line

\_\_\_\_\_ Ft. from S. Line

330 Ft. from E. Line

\_\_\_\_\_ Ft. from W. Line

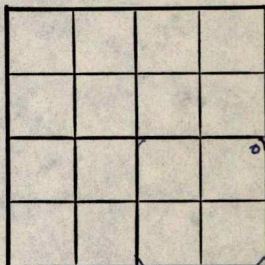

Rice County

Location X

Rig up \_\_\_\_\_

Drilling and Remarks:

RECORD

Cased \_\_\_\_\_ in., \_\_\_\_\_ ft.

Sand \_\_\_\_\_

Gas \_\_\_\_\_

Oil \_\_\_\_\_

Total Depth \_\_\_\_\_

PRODUCTION

1st 24 hrs. Nat. \_\_\_\_\_

1st 24 hrs. after shot \_\_\_\_\_

Gas \_\_\_\_\_ Cu. Ft.

Dry Hole \_\_\_\_\_

Abandoned \_\_\_\_\_

Date

JUN 11 1947 19

S. J. LEWIS Scout

Map No. 49 Sec. 15 Twp. 20 R. 8W

Well No. 1 Hutchins

Helmerich & Payne Company

**ABANDONED**

Contractor

NE SE

E11644  
**SECTION PLAT**

330 Ft. from N. Line

       Ft. from S. Line

330 Ft. from E. Line

       Ft. from W. Line

|  |  |  |   |
|--|--|--|---|
|  |  |  |   |
|  |  |  |   |
|  |  |  | 0 |
|  |  |  |   |

Rice County

Location                                 

Rig up                                 

Drilling and Remarks:


**RECORD**

Cased            in.,            ft.

Sand                                 

Gas                                 

Oil                                 


**PRODUCTION**

1st 24 hrs. Nat.                                 

1st 24 hrs. after shot                                 

Gas                                  Cu. Ft.

Dry Hole                                 

Abandoned                                 

Date

JUL 2 1947 19

S. J. LEWIS

Scout