




Rice

Map No. KANSAS Sec. 15 Twp. 20 R. 9W

Well No. 1- Dick Farm \_\_\_\_\_  
Gypsy Oil Company \_\_\_\_\_

330 Ft. from N. Line  
\_\_\_\_ Ft. from S. Line  
\_\_\_\_ Ft. from E. Line  
330 Ft. from W. Line  
**OFFSET**

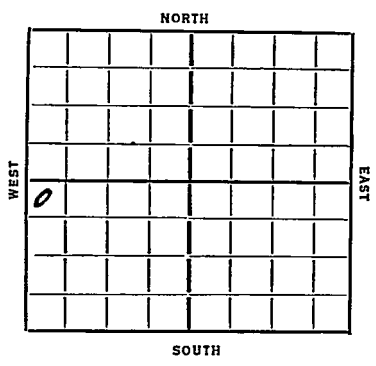

Date	Elev. 1715	REPORT
10/2		Ron Rotary
10/19		Dig 1739
11/1		Shot w/ 40 gts CO TD 3252 1/2
11/7		Set 3265 TD 3252 1/2
		Shot with 40 gts & shot hole
		in pipe
11/14		Shovel 331 Hbls 24 hrs.
11/21		" 536 " 15 "
11/29		1000 acid
		Pot tub pumped 755 oil
		15 hrs.
12/4		Set 3225
		TD 3252 1/2
		1000 acid
		1182 Hbls.

**COMPLETED**

Map No. 49 Sec. 15 Twp. 20 R. 9W

Well No. 1-lick

Kypsey oil Company

Contractor

### FIRST REPORTS

330 Ft. from N. Line

..... Ft. from S. Line

~~330~~ Ft. from E. Line

330 Ft. from W. Line

*[Handwritten signature]*

### SECTION PLAT

<u>0</u>	<u>0</u>		

Location 1-lick

Rig up .....

Drilling and Remarks:

*Rign Rotary*

### RECORD

Cased.....in., .....ft.

Sand.....

Gas.....

Oil.....

Total Depth.....

### PRODUCTION

1st 24 hrs. Nat.....

1st 24 hrs. after shot.....

Gas.....Cu. Ft.

Dry Hole.....

Abandoned.....

Date

10-2-35 192.....

**ORVAL MANNSCHECK**

Scout

Map No. 49 Sec. 15 Twp. 20 R. 9 W

Well No. 1-lick

Hydro oil

Company

Contractor

**COMPLETE**

**SECTION PLAT**

330 Ft. from N. Line

.....Ft. from S. Line

.....Ft. from E. Line

330 Ft. from W. Line

0			

Location.....

Rig up.....

Drilling and Remarks:

1000 acid

1182 lbs

**RECORD**

Cased.....in., .....ft.

Sand Sil 3225

Gas.....

Oil.....

Total Depth. 3252 1/2

**PRODUCTION**

1st 24 hrs. Nat.....

1st 24 hrs. after shot.....

Gas.....Cu. Ft.

Dry Hole.....

Abandoned.....

Date

12-4-35 192

**ORVAL MANNSCHRECK**

Scout