

Map No. _____ Sec. 15 Twp. 20 R. 9W

Well No. 1 Dick

Lindas Oil Company

FIRST REPORT Contractor

SE NW SW


SECTION PLAT

990 Ft. from N. Line

_____ Ft. from S. Line

_____ Ft. from E. Line

990 Ft. from W. Line

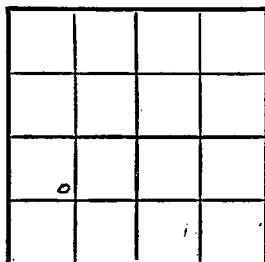

Rice County

Location _____

Rig up _____

Drilling and Remarks:

10" @ 156

drlg. 2334

RECORD

Cased _____ in., _____ ft.

Sand _____

Gas _____

Oil _____

Total Depth _____

PRODUCTION

1st 24 hrs. Nat. _____

1st 24 hrs. after shot _____

Gas _____ Cu. Ft.

Dry Hole _____

Abandoned _____

Date

DEC 10 1947

19

S. J. LEWIS

Scout

Map No. 49 Sec. 15 Twp. 20 R. 9W

Well No. 1 Dick

Lindas Oil

Company

COMPLETE

Contractor

SE NW SW


E11710
SECTION PLAT

990 Ft. from N. Line

 Ft. from S. Line

 Ft. from E. Line

990 Ft. from W. Line

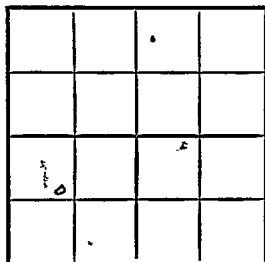

Rice County

Location

Rig up

Drilling and Remarks:

Art 3223

5' @ 3224

Pump 50 Bb

412 Bb

RECORD

Cased in., ft.

Sand

Gas

Oil ✓

Total Depth 3228 ft

PRODUCTION

1st 24 hrs. Nat.

1st 24 hrs. after shot

Gas Cu. Ft.

Dry Hole

Abandoned

Date

JAN 1 4 1948

19

S. J. LEWIS

Scout

KANSAS **HOT FILE**
Rice

Sec. 15 Twp. 20 R. 9-W

Well No. #1 Dick Farm

Lindas Oil Company

Chase Pool


990' Ft. from N. Line

 Ft. from S. Line

 Ft. from E. Line

990' Ft. from W. Line

SE NW SW

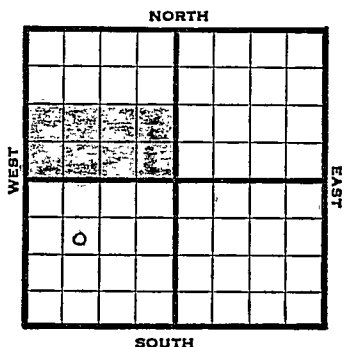

1947 Elev. 1710' REPORT

12/10 10" @ 156'
Dr1g. 2334'

12/17 Arbuckle 3223'
TD 3225'
5" @ 3224'
RUST

12/30 TD 3228'
1500' oil in 14 hrs.

1948
1/7 Brown Lime 2869'
Lansing 2890'
BKC 3202'

1/14 Arb. 3223'
5" @ 3224'
Pump 50 Pot
41.7 Gr.
TD 3228'

COMPLETED

Section 15 Township 20 Range 9W

Well No. 1 Dick

Company Lindas Oil

