


Map No. **KANSAS** Sec. **15** Twp. **20** R. **9W** *Rice*Well No. *1-11111* *Shupay oil* Farm _____ Company _____

NORTH

WEST

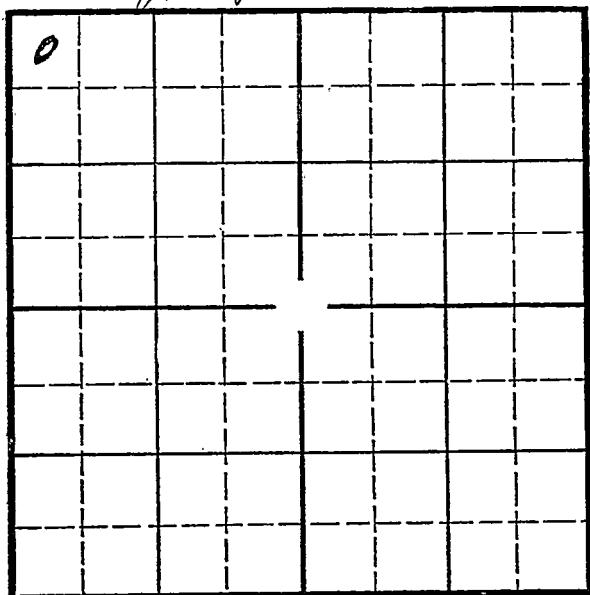

EAST

SOUTH

Location _____

Drilling Remarks _____

Rig Up _____

Drilling Remarks _____

RECORD

Cased _____ in. _____ ft.

Sand _____

Gas _____

Oil _____

Total Depth _____

PRODUCTION

1st 24 hrs. Nat. _____

1st 24 hrs. after shot _____

Gas _____ cu. ft. _____

Dry Hole _____

Abandoned _____

KANSAS

Map No. _____ Sec. 15 Twp. 20 R. 9W

Well No. 1 Hartle Farm

Gypsy oil Company


330 Ft. from N. Line

_____ Ft. from S. Line

_____ Ft. from E. Line

330 Ft. from W. Line

Elev. 1707

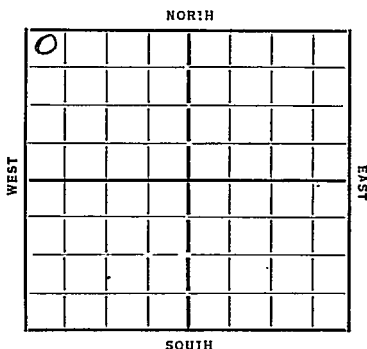

Date

REPORT

7/9/35
8/7 Cellar
8/15 Rm.
8/22 1660 10" 194
8/29 " 2995
9/6 Sib 3211 T 7 3213
9/20 Sib 3211
T 7 3231
1000 acid
1130 Blw.

COMPLETED

Map No. 49 Sec. 15 Twp. 20 R. 9W

Well No. 1-4 little

Hydro oil Company

Contractor

FIRST REPORTS

330 Ft. from N. Line

..... Ft. from S. Line

..... Ft. from E. Line

330 Ft. from W. Line

SECTION PLAT

0			

Location.....

Rig up.....

Drilling and Remarks:

RECORD

Cased.....in.,ft.

Sand.....

Gas.....

Oil.....

Total Depth.....

PRODUCTION

1st 24 hrs. Nat.....

1st 24 hrs. after shot.....

Gas.....Cu. Ft.

Dry Hole.....

Abandoned.....

Date

1921 MANNSCHRECK

8-7-35 192.....

Scout

Map No. 49 Sec. 15 Twp. 20 R. 9WWell No. 1-HartleHyess oil Company

Contractor

COMPLETED KANSAS

SECTION PLAT

330 Ft. from N. Line

Ft. from S. Line

Ft. from E. Line

330 Ft. from W. Line

0			

Location

Rig up

Drilling and Remarks:

1000 and1130 fths

RECORD

Cased _____ in., _____ ft.

Sand oil 3211

Gas _____

Oil _____

Total Depth 3231

PRODUCTION

1st 24 hrs. Nat. _____

1st 24 hrs. after shot _____

Gas _____ Cu. Ft.

Dry Hole _____

Abandoned _____

Date

9-20-35 192

J. W. ALMANNSCHRECK

Scout