

KANSAS

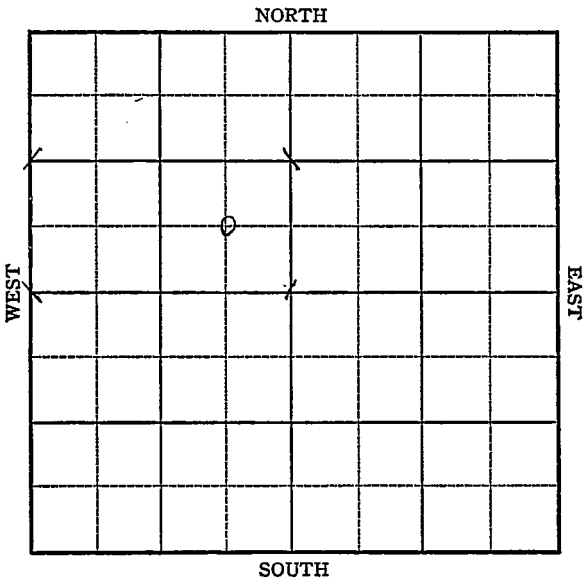
Rice

FORM 51 5M 10-41 PETROL

Section 16 Township 20 Range 9-W

Well No. #1 McGlynn "B"

Company Cities Service Oil

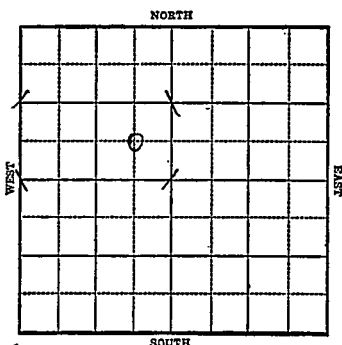


KANSAS

Rice

Sec. 16 Twp. 20 R. 9-WWell No. #1 McGlynn "B" FarmCities Service Oil Company

Chase

 Ft. from N. Line660 Ft. from S. Line660 Ft. from E. Line Ft. from W. LineC SE NW el. 1726

1943

R E P O R T

2/3 Location.

2/10 Rotary

2/17 8" Casing set 194
Drlg. 446'2/24 Arb 3241
TD 3247
Run Csg.3/3 5" Casing set 3241
TD 3258-800' oil 9½ hrs.

3/10 1000 acid Temp pump pot. 326

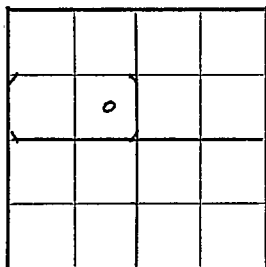
3/17 Arb. 3241
5" @ 3241'
T.D. 3253'
1000 gal acid
Pump 326Pot
Gravity 43.8**COMPLETED**

KANSAS Rice

Map No. 4/9 Sec. 16 Twp. 20 R. 9WWell No. 1 McGlynn "B"Cities Service Oil CompanyFIRST REPORT Contractor

C SE NW

SECTION PLAT

 Ft. from N. Line660 Ft. from S. Line660 Ft. from E. Line Ft. from W. Line

CHASE POOL

Location XXXRig up

Drilling and Remarks:

RECORD

Cased in., ft.Sand Gas Oil Total Depth

PRODUCTION

1st 24 hrs. Nat. 1st 24 hrs. after shot Gas Cu. Ft.Dry Hole Abandoned

Date

FEB 3 1943 19S. J. LEWIS Scout

KANSAS

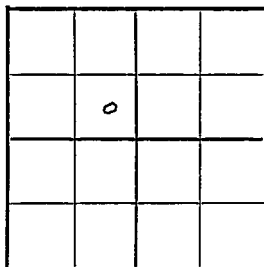
Rice

Map No. 49 Sec. 16 Twp. 20 R. 9WWell No. 1 McGlynn "B"Cities Service Oil Company**COMPLETED**

Contractor

C SE NW

SECTION PLAT

 Ft. from N. Line660 Ft. from S. Line660 Ft. from E. Line Ft. from W. Line

CHASE POOL

Location Rig up

Drilling and Remarks:

*Cs 3241**5" @ 3241**1000 Acid**Pump 326 P.S.**43 E Gr*

RECORD

Cased in., ft.Sand Gas Oil Total Depth 3253

PRODUCTION

1st 24 hrs. Nat. 1st 24 hrs. after shot Gas Cu. Ft.Dry Hole Abandoned

Date

MAR 17 1943

19

S. J. LEWIS Scout