


Section 16 Township 20 Range 9-W

Well Number 1-School Lot


Company Robertson Bros.

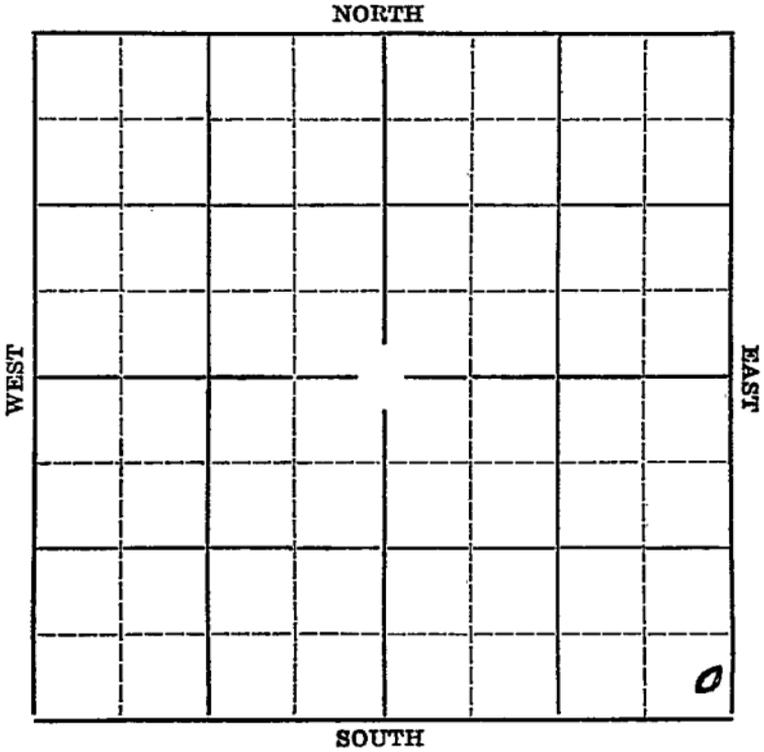

Map No. KANSAS Sec. 16 Twp. 20 R. 9-W

Well No. 1-School Lot Farm  
Robertson Bros. Company

         Ft. from N. Line  
150 Ft. from S. Line  
150 Ft. from E. Line  
         Ft. from W. Line

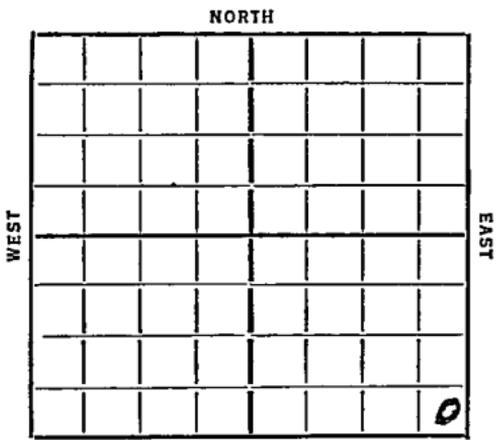

(Drilling on 1 acre)

Date 1936	REPORT
4/22	Location
4/30	653' crooked hole. P.B. 250'.
5/7	Drlg. 555'.
5/14	Drlg. 1215'.
5/21	--
5/28	Drlg. 1775'.
6/4	1850' S.D.
6/11	Fishing.
6/18	--6/25--
7/2	10" @ 1874'. Drlg. 2175a.
7/9	Drlg. 2420'.
7/16	Drlg. 2770'. 8" @ 2486'.
7/23	3175' shut down.
7/29	/36-Sil. 3272'.
	Hole full of water 3290'.
	T.D. 3300'.
	Dry and abandoned.
	<b>ABANDONED</b>

Map No. 49 Sec. 16 Twp. 20 R. 9 N

Well No. 1 School Lot

Robertson Bros. Company

Contractor

**SECTION PLAT**


..... Ft. from N. Line

156 Ft. from S. Line

150 Ft. from E. Line

..... Ft. from W. Line

**FIRST REPORT**

Location ✓

Rig up .....

Drilling and Remarks:

Drilling on 1 acre

**RECORD**

Cased..... in., ..... ft.

Sand.....

Gas.....

Oil.....

Total Depth.....

**PRODUCTION**

1st 24 hrs. Nat.....

1st 24 hrs. after shot.....

Gas..... Cu. Ft.

Dry Hole.....

Abandoned.....

Date

APR 22 1936 192.....

S. J LEWIS Scout

Map No. 49 Sec. 16 Twp. 20 R. 9W

Well No. 1 School 1st

Robertson Bros. Company

Contractor

SECTION PLAT


\_\_\_\_\_ Ft. from N. Line

150 Ft. from S. Line

150 Ft. from E. Line

\_\_\_\_\_ Ft. from W. Line

**ABANDONED**

Location \_\_\_\_\_

Rig up \_\_\_\_\_

Drilling and Remarks:

Oil 3272.  
NFW 3290

J. A. L.

RECORD

Cased \_\_\_\_\_ in., \_\_\_\_\_ ft.

Sand \_\_\_\_\_

Gas \_\_\_\_\_

Oil \_\_\_\_\_

Total Depth 3200

PRODUCTION

1st 24 hrs. Nat. \_\_\_\_\_

1st 24 hrs. after shot \_\_\_\_\_

Gas \_\_\_\_\_ Cu. Ft.

Dry Hole \_\_\_\_\_

Abandoned \_\_\_\_\_

Date

JUL 29 1936 19

S. J. LEWIS Scout