


Section 16 Township 20 Range 9-W

Well No. #1 Argo-Smith

Company Bay Petroleum

Chase Pool

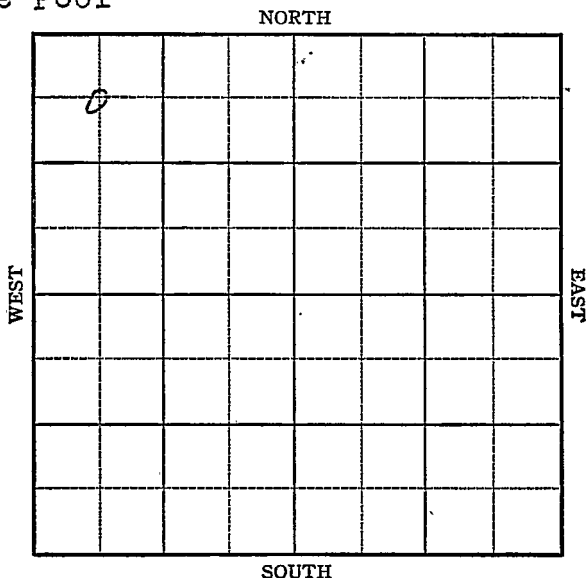

KANSAS Rice

Sec. 16 Twp. 20 R. 9-W

Well No. #1 Argo-Smith Farm

Bay Petroleum Company

(Chase Pool)


660 Ft. from N. Line

Ft. from S. Line

Ft. from E. Line

660 Ft. from W. Line

Elev. 1743

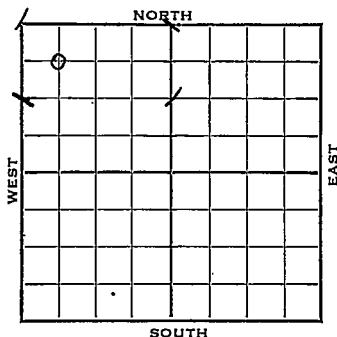

1942

REPORT

9/16 8" - 135' Drlg. 1365'

9/23 Topeka 2575 Lans 2940 Drlg 3081

9/30 TD 3276 Tstg - treat 500
Arb. 3269-71 swab 4 boph on 6 hr test
5" - 3220

10/7 Shot 7 qts.

10/14 1500 acid. 600' oil 5 hrs.

10/21 Arb. 3269 5" @ 3270

11 qts

T.D. 3276

2000 Acid

Pump 198 Pot.

43.2 Gravity

COMPLETED


Rice

Map No. 49 Sec. 16 Twp. 20 R. 9WWell No. 1 Argo-SmithBay Petroleum CompanyFIRST REPORT Contractor

C NW NW

660 Ft. from N. Line Ft. from S. Line Ft. from E. Line660 Ft. from W. Line

SECTION PLAT

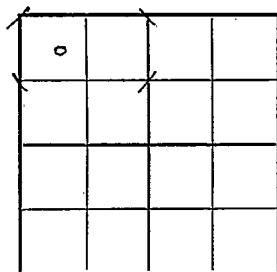

CHASE POOL

Location Rig up Drilling and Remarks:

8"-135'

Dr1 g. 1365'

RECORD

Cased in., ft.Sand Gas Oil Total Depth

PRODUCTION

1st 24 hrs. Nat. 1st 24 hrs. after shot Gas Cu. Ft.Dry Hole Abandoned

Date

SEP 16 1942

19

S. J. LEWIS

Scout

Rice

KANSAS

Map No. 49 Sec. 16 Twp. 20 R. 9WWell No. 1 Argo-Smith

Bay Petroleum

Company

COMPLETED

Contractor

C NW NW

660 Ft. from N. Line

Ft. from S. Line

Ft. from E. Line

660 Ft. from W. Line

SECTION PLAT

0			

CHASE POOL

Location _____

Rig up _____

Drilling and Remarks:

*Ar 8269**5" 8270**119 ft.**2000 acid**Pump 198 ft.**432 ft.*

RECORD

Cased _____ in., _____ ft.

Sand _____

Gas _____

Oil _____

Total Depth 8276

PRODUCTION

1st 24 hrs. Nat. _____

1st 24 hrs. after shot _____

Gas _____ Cu. Ft.

Dry Hole _____

Abandoned _____

Date

OCT 21 1942

19

S. J. LEWIS Scout