


# KANSAS Rice

FORM 51 5M PETROL

Section 16 Township 20 Range 9W


Well No. 2 Smith "B"

Company C. U. Bay

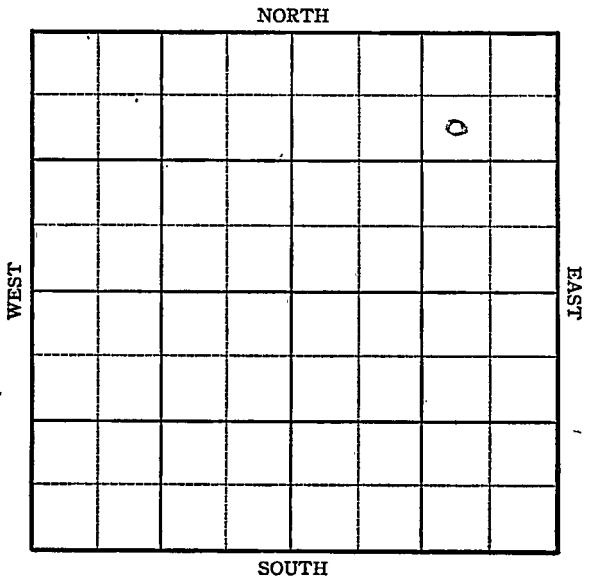

Sec. 16 Twp. 20 R. 9-WWell No. #2 Smith "B" FarmC. U. Bay Company990 Ft. from N. Line       Ft. from S. Line990 Ft. from E. Line       Ft. from W. Line

SW NE NE

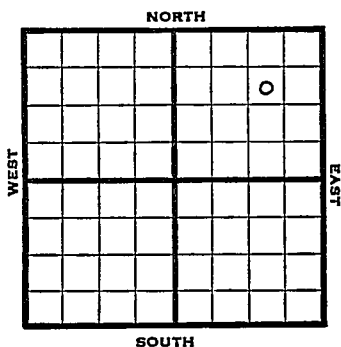

1945 Elev. 1721 REPORT

11/21 RUR

11/28 8" @ 208  
Arb. 3221  
TD 3224  
5" @ 3222 RUST

12/5 TD 3226'

12/12 TD 3231  
500 acid.  
Swb. 2 oil per hr.

12/20 " " "

12/28 Arb. 3221  
5" @ 3222  
500 acid.  
TD 3231  
Pump 50 Pot.  
Grav. 42.0

COMPLETED

Kansas Pool Name SilicaKANSAS  
Map No. 49 Sec. 16 Twp. 20 R. 9WWell No. 2 Smith "B"C. U. Bay Company

FIRST REPORT Contractor

SW NE NE

## SECTION PLAT

|  |  |  |   |
|--|--|--|---|
|  |  |  |   |
|  |  |  | 6 |
|  |  |  |   |
|  |  |  |   |
|  |  |  |   |

990 Ft. from N. Line       Ft. from S. Line990 Ft. from E. Line       Ft. from W. Line

Rice County

Location       Rig up       

Drilling and Remarks:

R U R

## RECORD

Cased        in.,        ft.Sand       Gas       Oil       Total Depth       

## PRODUCTION

1st 24 hrs. Nat.       1st 24 hrs. after shot       Gas        Cu. Ft.Dry Hole       Abandoned       

Date

NOV 21 1945 19S. J. LEWIS Scout

KANSAS Kansas Pool Name Silica PoolMap No. 1-49 Sec. 16 Twp. 20 R. 9WWell No. 2 Smith "B"C. U. Bay Company

COMPLETED

Contractor

SW NE NE

E1.1721  
SECTION PLAT990 Ft. from N. Line       Ft. from S. Line990 Ft. from E. Line       Ft. from W. Line

|  |  |  |   |
|--|--|--|---|
|  |  |  |   |
|  |  |  | 9 |
|  |  |  |   |
|  |  |  |   |
|  |  |  |   |

Rice County

Location       Rig up       

Drilling and Remarks:

*Per 83221*  
*5" 83222*  
*500 acid*  
*Pump 50 Bx*

*42 1/2 ft*

## RECORD

Cased        in.,        ft.Sand       Gas       Oil       Total Depth 3231

## PRODUCTION

1st 24 hrs. Nat.       1st 24 hrs. after shot       Gas        Cu. Ft.Dry Hole       Abandoned       

Date

DEC 28 1945

19

S. J. LEWIS

Scout