


Map No. NSAS Sec. 16 Twp. 20 R. 9WWell No. Smith FarmMagnolia Company

NORTH

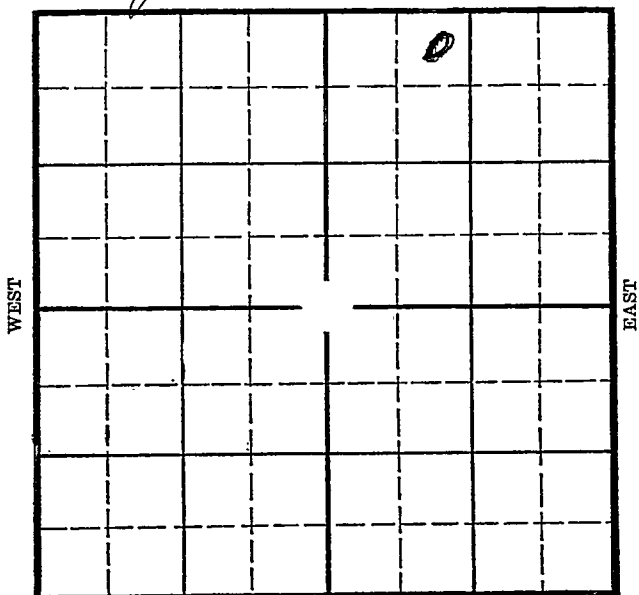

SOUTH

Location _____

Drilling Remarks _____

RECORD

Cased _____ in. _____ ft.

Sand _____

Gas _____

Oil _____

Total Depth _____

Rig Up _____

Drilling Remarks _____

PRODUCTION

1st 24 hrs. Nat. _____

1st 24 hrs. after shot _____

Gas _____ cu. ft. _____

Dry Hole _____

Abandoned _____

Rice

Map No. KANSAS Sec. 16 Twp. 20 R. 9W

Well No. 1- Smith Farm
Magnolia Company


330 Ft. from N. Line

_____ Ft. from S. Line

_____ Ft. from E. Line

990 Ft. from W. Line

Elev. 1727

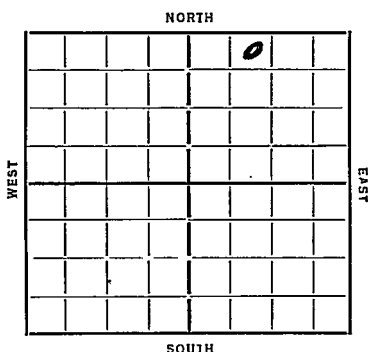

Date 7/23

REPORT

6/26 Cellar
7/3 Rig
7/11 12" 210 WOC
7/18 _____
8/8 Sil 3248 7" Rust
8/15 3273 T7 2 Bbls per hr
8/21 2000 acid
8/21 Sil 3248
8/21 T7 3273
8/21 2000 acid
70 ft.

ABANDONED

Map No. 49 Sec. 16 Twp. 20 R. 9 W

Well No. 1 Smith

Magnolia Company

Contractor

SECTION PLAT

		0	

330 Ft. from N. Line

..... Ft. from S. Line

..... Ft. from E. Line

790 Ft. from W. Line

FIRST REPORTS

Location.....

Rig up.....

Drilling and Remarks:

Cellar

RECORD

Cased.....in., ...ft.

Sand.....

Gas.....

Oil.....

Total Depth.....

PRODUCTION

1st 24 hrs. Nat.....

1st 24 hrs. after shot.....

Gas.....Cu. Ft.

Dry Hole.....

Abandoned.....

Date

ORVAL MANNSCHRECK

6/26/35 192.....Scout

Map No. 49 Sec. 16 Twp. 20 R. 9NWell No. 1-SmithMagnolia Petroleum Company

Contractor

ABANDONE

SECTION PLAT

330 Ft. from N. Line

Ft. from S. Line

Ft. from E. Line

990 Ft. from W. Line

		0	

Location

Rig up

Drilling and Remarks:

2000 andD & A

RECORD

Cased _____ in., _____ ft.

Sand Oil 3248

Gas _____

Oil _____

Total Depth 3273

PRODUCTION

1st 24 hrs. Nat. _____

1st 24 hrs. after shot _____

Gas _____ Cu. Ft.

Dry Hole _____

Abandoned _____

Date

8-21-35 192

ORVAL MANNSCHRECK

Scout