


KANSAS

Section 16 Township 20 Range 9THWell No. #1 WhiteCompany Derby Drlg. & Schio

NORTH

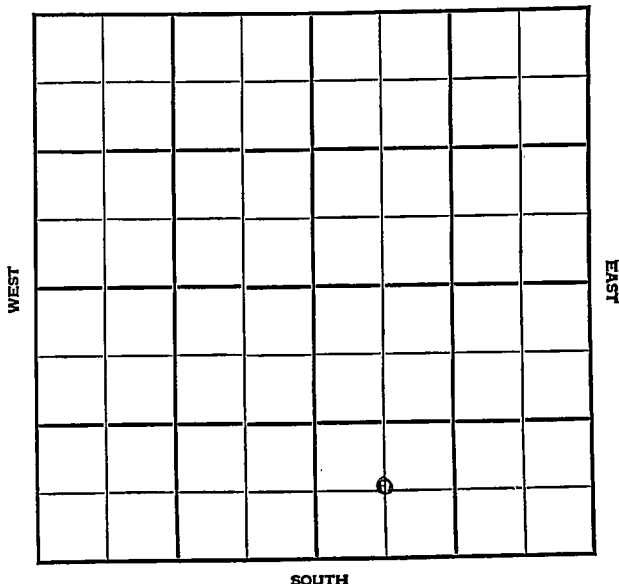

KANSAS

Rice

Sec. 16 Twp. 20 R. 9-W

Well No. #1 White Farm

Derby Drlg. & Sohio Company

Chase Pool


 Ft. from N. Line

330' Ft. from S. Line

 Ft. from E. Line

330' Ft. from W. Line

SW SE

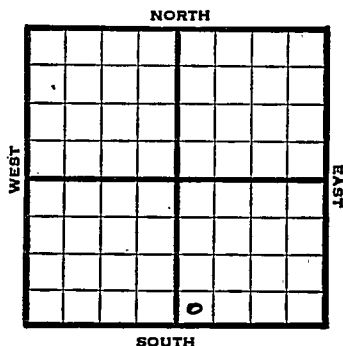

1947

R E P O R T

11/25

8" @ 175'
Drlg. 825'

12/3

Lansing 2938'
Simpson 3267'
Arbuckle 3270'
TD 3273'
5" @ 3271'
RUST

12/10

Arbuckle 3270'
5" @ 3271'
Pump 75 Pot
Gr. 42°
Total Depth 3281'

COMPLETED

Map No. _____ Sec. 16 Twp. 20 R. 9W

Well No. 1 White


Derby Drlg. & Sohio Company

FIRST REPORT

Contractor

SW SE

SECTION PLAT

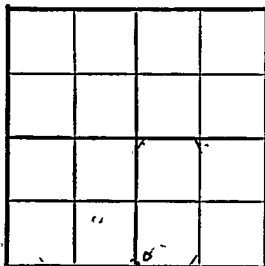

_____ Ft. from N. Line

330 Ft. from S. Line

_____ Ft. from E. Line

330 Ft. from W. Line

Rice County

Location _____

Rig up _____

Drilling and Remarks:

8" @ 175

drlg. 825

RECORD

Cased _____ in., _____ ft.

Sand _____

Gas _____

Oil _____

Total Depth _____

PRODUCTION

1st 24 hrs. Nat. _____

1st 24 hrs. after shot _____

Gas _____ Cu. Ft.

Dry Hole _____

Abandoned _____

Date

NOV 25 1947 19

S. J. LEWIS

Scout


Kansas

Map No. 49 Sec. 16 Twp. 20 R. 9WWell No. 1 WhiteDerby Drlg. & Sohio Company

COMPLETE

Contractor

SW SE

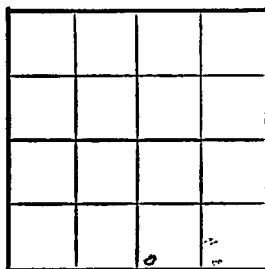E11742
SECTION PLAT Ft. from N. Line330 Ft. from S. Line Ft. from E. Line330 Ft. from W. LineRice CountyLocation Rig up

Drilling and Remarks:

CR 822705" @ 327'Pump 75 Bbl.42 c/s

RECORD

Cased in., ft.Sand Gas Oil Total Depth 0287

PRODUCTION

1st 24 hrs. Nat. 1st 24 hrs. after shot Gas Cu. Ft.Dry Hole Abandoned

Date

DEC 10 1947 19S. J. LEWIS

Scout