


KANSAS

Rice


Section 16 Township 20 Range 9WWell No. #2 Argo-SmithCompany Bay Petroleum

Chase Pool

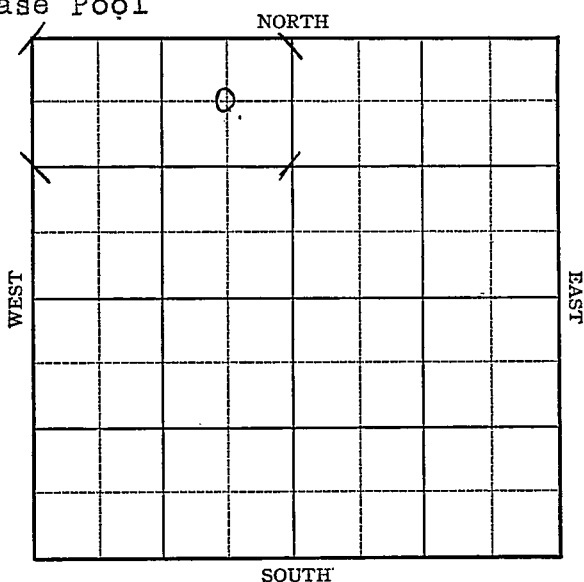

KANSAS

Rice

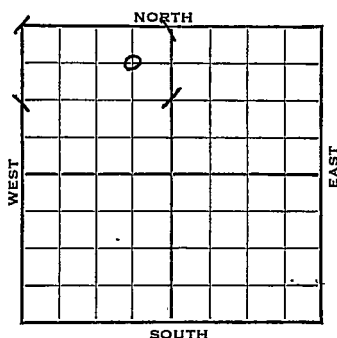Sec. 16 Twp. 20 R. 9WWell No. #2 Argo-Smith FarmBay Petroleum CompanyChase ^{is} Pool660 Ft. from N. Line Ft. from S. Line660 Ft. from E. Line Ft. from W. Line

C NE NW

1942

REPORT

11/10	Location
11/18	"
11/24	"
12/2	8" @ 146 Anhy 317 Drlg. 2255
12/9	Lans 2916 Arp 3253-55 TD Run Csg.
12/16	5" @ 3254 Drlg. 3263 200' oil in 4 hrs.
12/22	TD 3265' 1500 gal. acid.
12/29	Temp. Pot. 62
1943	
1/6	T. D. 3205' 1500 ga. acid. Temp. Pot. 62 TD 3245' " " " "

OVER

1943 TD '3265'

1/20 Arb 3253

5" Casing set 3254'

1500 acid pump 550 Pot. & 2%
water.

45 Gravity.

TD 3265'

COMPLETED

KANSAS


Rice

Map No. 49 Sec. 16 Twp. 20 R. 9WWell No. 2 Argo-SmithBay Petroleum CompanyFIRST REPORT Contractor

C NE NW

660 Ft. from N. Line Ft. from S. Line660 Ft. from E. Line Ft. from W. Line

SECTION PLAT

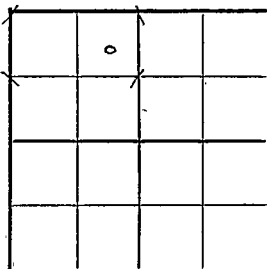

CHASE POOL

Location XXXRig up

Drilling and Remarks:

RECORD

Cased in., ft.Sand Gas Oil Total Depth

PRODUCTION

1st 24 hrs. Nat. 1st 24 hrs. after shot Gas Cu. Ft.Dry Hole Abandoned

Date

NOV 1 1 1942

19

S. J. LEWIS

Scout

KANSASMap No. 49 Sec. 16 Twp. 20 R. 9WWell No. 2 **Argo-Smith****Bay Petroleum**

Company

COMPLETED

Contractor

C NE NW**SECTION PLAT**

	D		

660 Ft. from N. Line Ft. from S. Line660 Ft. from E. Line Ft. from W. Line**CHASE POOL**Location Rig up

Drilling and Remarks:

*Cor Y3203**5" C3204**1500 Acid
Pump 550 P.S.
+ 2% Water.**450 Gr***RECORD**Cased in., ft.Sand Gas Oil Total Depth 3265**PRODUCTION**1st 24 hrs. Nat. 1st 24 hrs. after shot Gas Cu. Ft.Dry Hole Abandoned

Date

JAN 20 1943 19 S. J. LEWIS Scout