


Section 16 Township 20 Range 9-W

Well No. #2 McGlynn "B"

Company Cities Service Oil

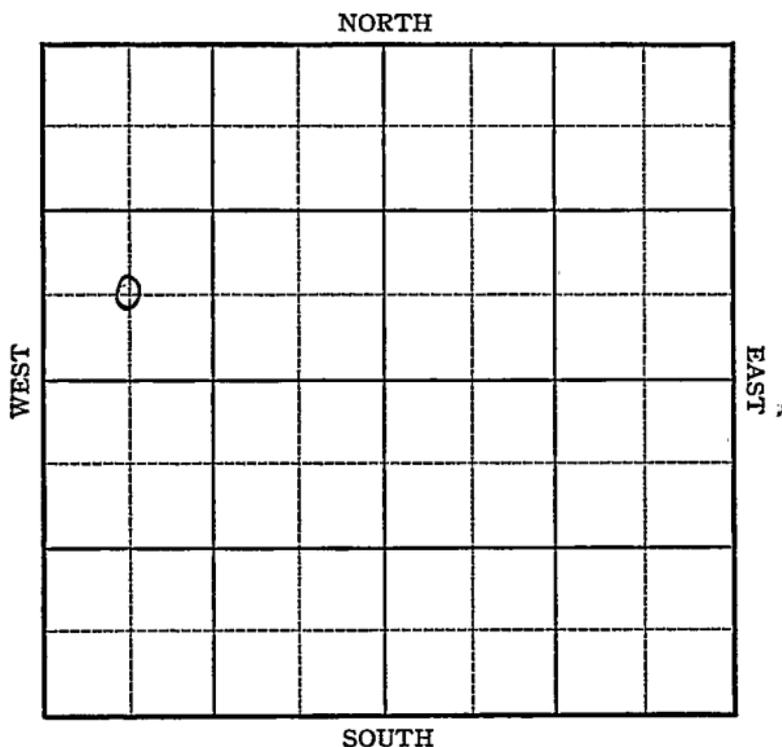

Sec. 16 Twp. 20 R. 9-W

Well No. #2 McGlynn "B" Farm

Cities Service Oil Company


Chase,

\_\_\_\_\_ Ft. from N. Line

660 Ft. from S. Line

\_\_\_\_\_ Ft. from E. Line

660 Ft. from W. Line

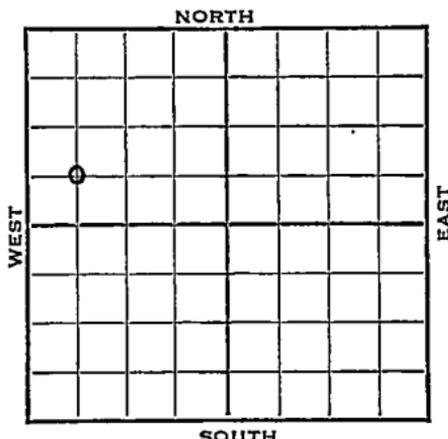

1943

### REPORT

3/3 10" Casing set 185'  
Drlg. 1963'

3/10 Arb 3281  
Drlg. 3291 stains.

3/17 Arb. 3281  
T.D. 3314'  
No shows.

## ABANDONED

**KANSAS**

Rice

Map No. 49 Sec. 16 Twp. 20 R. 9W

Well No. 2 McGlynn "B"

Cities Service Oil Company

**FIRST REPORT**

Contractor

C SW NW

**SECTION PLAT**

\_\_\_\_\_ Ft. from N. Line

660 Ft. from S. Line

\_\_\_\_\_ Ft. from E. Line

660 Ft. from W. Line

o			

**CHASE POOL**

Location \_\_\_\_\_

Rig up \_\_\_\_\_

Drilling and Remarks:

10" - 185'

Drlg. 1963'

**RECORD**

Cased \_\_\_\_\_ in., \_\_\_\_\_ ft.

Sand \_\_\_\_\_

Gas \_\_\_\_\_

Oil \_\_\_\_\_

Total Depth \_\_\_\_\_

**PRODUCTION**

1st 24 hrs. Nat. \_\_\_\_\_

1st 24 hrs. after shot \_\_\_\_\_

Gas \_\_\_\_\_ Cu. Ft.

Dry Hole \_\_\_\_\_

Abandoned \_\_\_\_\_

Date

MAR 3 1943 19

S. J. LEWIS Scout

Rice

KANSAS

Map No. 49 Sec. 16 Twp. 20 R. 9WWell No. 2 McGlynn "B"Cities Service Oil CompanyABANDONED

Contractor

C SW NW

## SECTION PLAT

o			

\_\_\_\_\_ Ft. from N. Line

660 Ft. from S. Line

\_\_\_\_\_ Ft. from E. Line

660 Ft. from W. Line

## CHASE POOL

Location \_\_\_\_\_

Rig up \_\_\_\_\_

Drilling and Remarks:

Cu 83281Nichols

## RECORD

Cased \_\_\_\_\_ in., \_\_\_\_\_ ft.

Sand \_\_\_\_\_

Gas \_\_\_\_\_

Oil \_\_\_\_\_

Total Depth 2314

## PRODUCTION

.1st 24 hrs. Nat. \_\_\_\_\_

1st 24 hrs. after shot \_\_\_\_\_

Gas \_\_\_\_\_ Cu. Ft.

Dry Hole \_\_\_\_\_

Abandoned \_\_\_\_\_

Date

MAR 17 1943 19S. J. LEWIS Scout