


Form 51-5M-3-35-Mid-West

Map No. **KANSAS** Sec. **16** Twp. **20-** R. **9-W**

Well No. **2-Smith** Farm
Stanolind Oil Company

NORTH

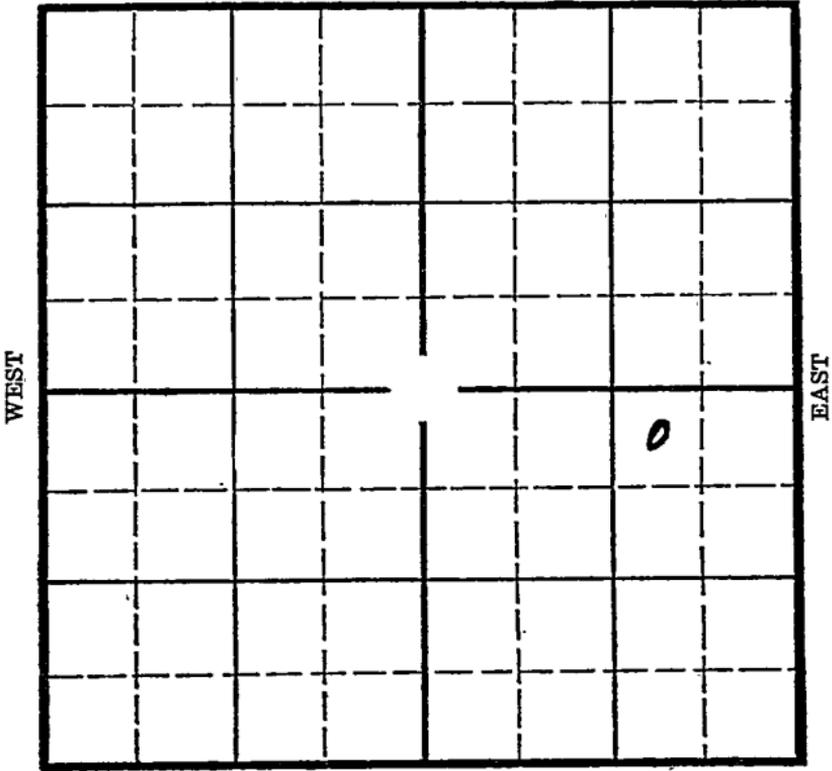

SOUTH

Location _____
Drilling Remarks _____

Rig Up _____
Drilling Remarks _____

RECORD

PRODUCTION

Cased _____ in. _____ ft.
Sand _____
Gas _____
Oil _____
Total Depth _____

1st 24 hrs. Nat. _____
1st 24 hrs. after shot _____
Gas _____ cu. ft. _____
Dry Hole _____
Abandoned _____

Map No. KANSAS Sec. 16 Twp. 20 R. 9W *Rice*

Well No. 2-Smith Farm
Standard Oil Company


330 Ft. from N. Line

_____ Ft. from S. Line

990 Ft. from E. Line

_____ Ft. from W. Line

Elev. 1725

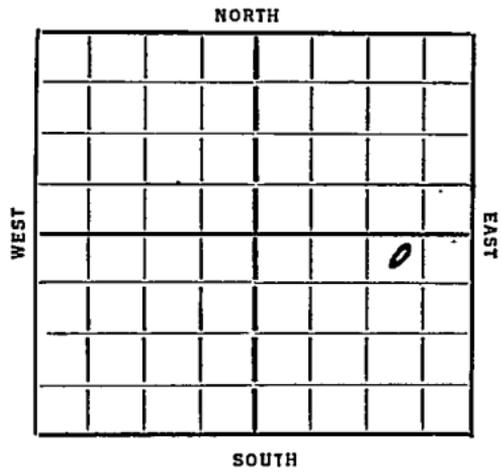

REPORT

1936

3/4 *Ponds*

3/13 *Spud*

3/20 *12"-175 Drlg. 2400'.*

3/27 *T. Sil. 3237 7"- 3237 T.D. 3242*

RUST.

4/2 *T.D. 3258' HFO. Swabbed 50 bbls*
per hr.- 2 hrs. Putting on pump.

4/8 *sil 3237*
TD 3241 1/2
pot 1273

COMPLETED

KANSAS

Map No. 49 Sec. 16 Twp. 20 R. 9W

Well No. 2-Smith

Stanolind Oil Company

Contractor

FIRST REPORTS

SECTION PLAT

330 Ft. from N. Line

..... Ft. from S. Line

990 Ft. from E. Line

..... Ft. from W. Line

			0

Location.....

Rig up.....

Drilling and Remarks:

ponds

RECORD

Cased.....in.,ft.

Sand.....

Gas.....

Oil.....

Total Depth.....

PRODUCTION

1st 24 hrs. Nat.....

1st 24 hrs. after shot.....

Gas.....Cu. Ft.

Dry Hole.....

Abandoned.....

Date

3-4-36 192

W. H. DAVIS

Scout

KANSAS

Map No. 49 Sec. 16 Twp. 20 R. 9 NWell No. 2 SmithStanford Company

Contractor

SECTION PLAT

330 Ft. from N. Line

..... Ft. from S. Line

990 Ft. from E. Line

..... Ft. from W. Line

			o

COMPLETED

Location.....

Rig up.....

Drilling and Remarks:

Sil 3237Potential
1273

RECORD

Cased..... in., ft.

Sand.....

Gas.....

Oil.....

Total Depth 324 1/2

PRODUCTION

1st 24 hrs. Nat.....

1st 24 hrs. after shot.....

Gas..... Cu. Ft.

Dry Hole.....

Abandoned.....

Date

4/8/36 192.....

S. J. LEWIS Scout