


Map No. 7 Sec. 16 Twp. 20 R. 9W

Well No. Smith Farm

Supersy Oil Company

NORTH

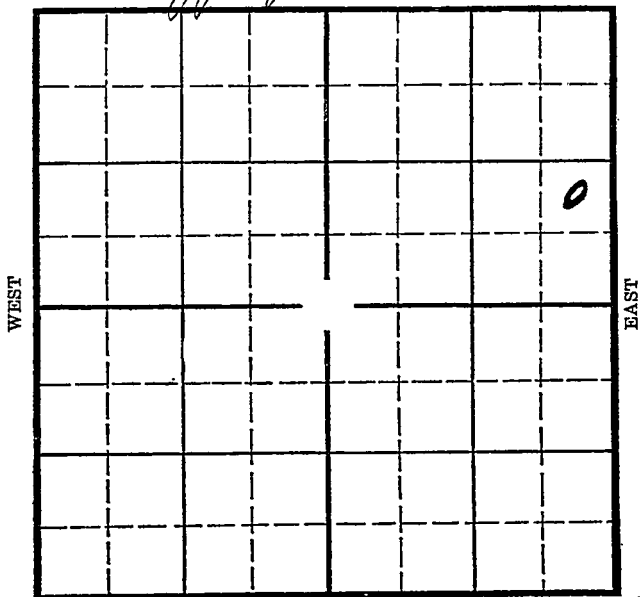

SOUTH

offset

Location _____

Drilling Remarks _____

Rig Up _____

Drilling Remarks _____

RECORD

Cased _____ in. _____ ft.

Sand _____

Gas _____

Oil _____

Total Depth _____

PRODUCTION

1st 24 hrs. Nat. _____

1st 24 hrs. after shot _____

Gas _____ cu. ft. _____

Dry Hole _____

Abandoned _____

Map No. KANSAS Sec. 16 Twp. 20 R. 9W *Rice*

Well No. 2-Smith Farm
Gypsy Oil Company


1650 Ft. from N. Line

_____ Ft. from S. Line

330 Ft. from E. Line

_____ Ft. from W. Line

Elev. 1709

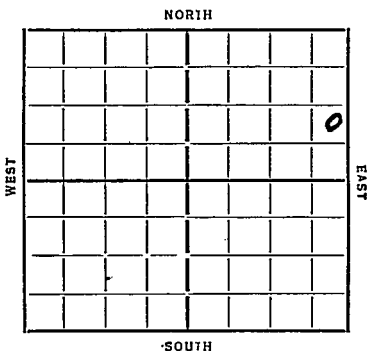

Date

REPORT

OFFSET

8/14 B. R.
 8/27 10" 186 w.o.c.
 8/29 log 1700
 9/6 " 3180
 9/25 Oil 3223
 T-1 3243
 1000 acid
 1078 Gals.

COMPLETED

KANSAS

Map No. 49 Sec. 16 Twp. 20 R. 9W

Well No. 2 - Smith

Kypsy oil Company
Contractor

FIRST REPORT

SECTION PLAT

1650 Ft. from N. Line

..... Ft. from S. Line

330 Ft. from E. Line

..... Ft. from W. Line

Offset

			o

FIRST REPORT

Location.....

Rig up.....

Drilling and Remarks:

BR

RECORD

Cased.....in.,ft.

Sand.....

Gas.....

Oil.....

Total Depth.....

PRODUCTION

1st 24 hrs. Nat.....

1st 24 hrs. after shot.....

Gas.....Cu. Ft.

Dry Hole.....

Abandoned.....

Date

ORVAL MANN CHECK

8-14-35 192.

Scout

KANSAS

Map No. 49 Sec. 16 Twp. 20 R. 9W

Well No. 2 - Smith

Kypsy Oil Co Company

Contractor

COMPLETED

SECTION PLAT

1650 Ft. from N. Line

..... Ft. from S. Line

330 Ft. from E. Line

..... Ft. from W. Line

			0

[Handwritten signature]

Location

Rig up

Drilling and Remarks:

100 acid

1078 bbls

RECORD

Cased in. ft.

Sand oil 3223

Gas

Oil

Total Depth 3243

PRODUCTION

1st 24 hrs. Nat.

1st 24 hrs. after shot.

Gas Cu. Ft.

Dry Hole

Abandoned

Date

W. L. WANNSCHECK

9-25-35 192

Scout