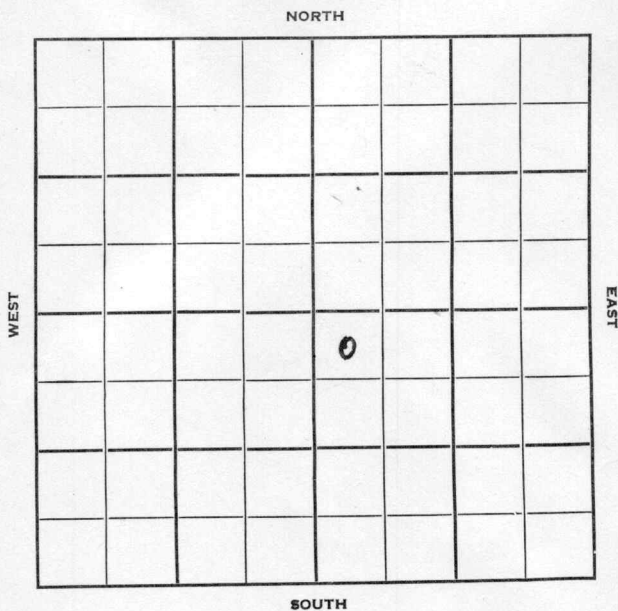


Rice


KANSAS

Section 16 Township 20 Range 7 WWell No. # 1 LeonardCompany O. A. Beech

Rice KANSAS

Sec. 16 Twp. 20 R. 7WWell No. #1 Leonard FarmO. A. Beech CompanyWildcat Contractor330 Ft. from N. Line Ft. from S. Line Ft. from E. Line330 Ft. from W. Line

NW NW SE

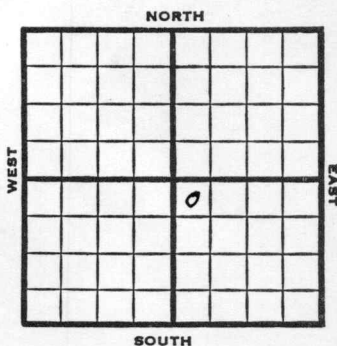

1952 Elev. 1703' REPORT

11/19 Spud 11-12-52
 8" @ 210'
 Drlg. 2349'

11/26 Spud 11-12-52
 D&A

TD 3730'

8" @ 210

Hiward 2398, Top. 2444', Heeb
 2740', Br. lime 2890', Lans

2924', B KC 3197', Cong 3301,

Miss. 3311, Kh. 3375, Maq. 3582,

Viola 3597', Simp. Dol 3627',

Simp. sd . 3631, Arb. 3695',

TD 3730'

D&A

ABANDONED

County **Rice** State **Kansas**

Sec. 16 (Blk. Twp.) 20 (Sur. Rge.) 7W Map No.

Operator O. A. Beech

Well No. **1** Farm **Leonard**

Elev.	Location	NW NW SE
-------	----------	----------

FIRST REPORT

0

330 Ft. From N Line SE

330 Ft. From **W** Line Quarter

1st. Report NOV 19 1952

Completion _____

Remarks _____

Spudding Date **11-12-52**

Drlg. Data Wildcat

8" @ 210 drlg. 2349

J. G. McGEHEE

