

STATE CORPORATION COMMISSION OF KANSAS
OIL & GAS CONSERVATION DIVISIONWELL COMPLETION OR RECOMPLETION FORM
ACO-1 WELL HISTORY

DESCRIPTION OF WELL AND LEASE

CONFIDENTIAL

Operator: License # 5140
 Name Frontier Oil Company
 Address 125 N. Market, Ste 1720
 City/State/Zip Wichita, Ks. 67202

Purchaser N/A

Operator Contact Person Jean Angle
 Phone 316-263-1201

Contractor: License # 5302
 Name Red Tiger Drilling Company

Wellsite Geologist Richard Parker
 Phone 913-483-5348

Designate Type of Completion

☒ New Well ☐ Re-Entry ☐ Workover
☐ Oil ☐ SWD ☐ Temp Abd
☐ Gas ☐ Inj ☐ Delayed Comp.
☒ Dry ☐ Other (Core, Water Supply etc.)

If OWM: old well info as follows:

Operator
 Well Name
 Comp. Date Old Total Depth

WELL HISTORY

Drilling Method:

☒ Mud Rotary ☐ Air Rotary ☐ Cable

2-17-85 2-27-85 7-11-85
 Spud Date Date Reached TD Completion Date
 4133' N/A
 Total Depth PBTD

Amount of Surface Pipe Set and Cemented at 219 feet
 Multiple Stage Cementing Collar Used? ☐ Yes ☐ No
 If yes, show depth set.....feet
 If alternate 2 completion, cement circulated
 from.....feet depth to.....w/.....SX cmt

API NO. 15-145-21-187

County Pawnee

SE NW NE Sec 21 Twp 20S Rge 18W ☒ West

4290 Ft North from Southeast Corner of Section
 1650 Ft West from Southeast Corner of Section
 (Note: Locate well in section plat below)


Lease Name Cox "A" Well # 1

Field Name (Wildcat)

Producing Formation N/A

Elevation: Ground 2202' KB 2207'

Section Plat

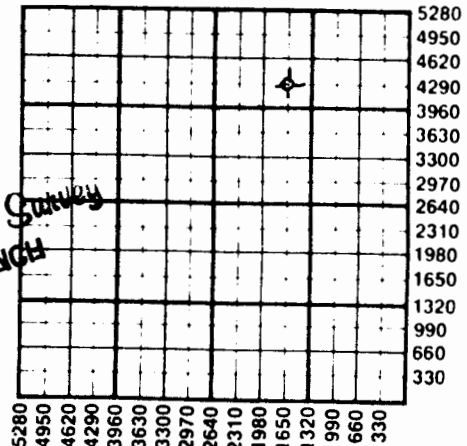

WATER SUPPLY INFORMATION

Disposition of Produced Water: N/A ☐ Disposal
 Docket # ☐ Repressuring

Questions on this portion of the ACO-1 call:

Water Resources Board (913) 296-3717

Source of Water:

Division of Water Resources Permit #

☐ Groundwater.....Ft North from Southeast Corner
 (Well)Ft West from Southeast Corner of
 Sec Twp Rge ☐ East ☐ West

☒ Surface Water 5000 Ft North from Southeast Corner
 (Stream, pond etc) 5000 Ft West from Southeast Corner
 Sec 20 Twp 20 Rge 17 ☐ East ☒ West

☐ Other (explain).....
 (purchased from city, R.W.D. #)

INSTRUCTIONS: This form shall be completed in duplicate and filed with the Kansas Corporation Commission, 200 Colorado Derby Building, Wichita, Kansas 67202, within 90 days after completion or recompletion of any well. Rule 82-3-130 and 82-3-107 apply.

Information on side two of this form will be held confidential for a period of 12 months if requested in writing and submitted with the form. See rule 82-3-107 for confidentiality in excess of 12 months.

One copy of all wireline logs and drillers time log shall be attached with this form. Submit CP-4 form with all plugged wells. Submit CP-111 form with all temporarily abandoned wells.