

Rice


KANSAS

FORM 51 25M 3-49 PETROL

Section 18 Township 20 Range 6W

Well No. #1 Burke

Company Atlantic

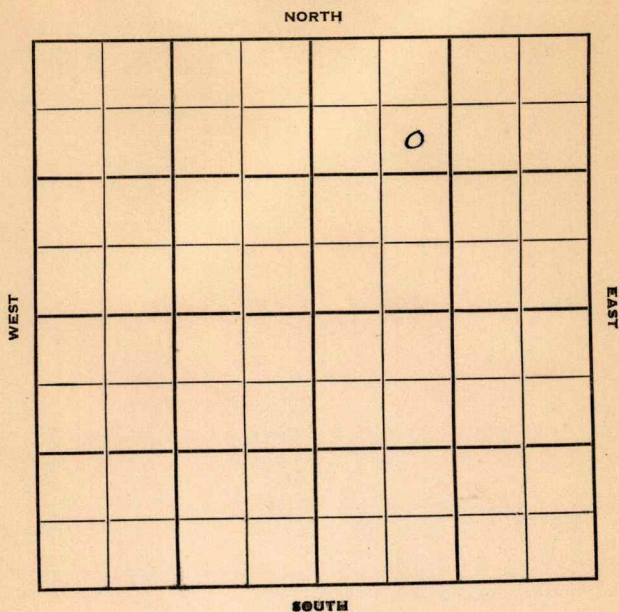

Rice **KANSAS**

Sec. 18 Twp. 20 R. 6W

Well No. #1 Burke Farm

Atlantic Company

Lohman & Johnson Contractor

Wildcat


990' Ft. from N. Line

 Ft. from S. Line

 Ft. from E. Line

990' Ft. from W. Line

SE NW NE

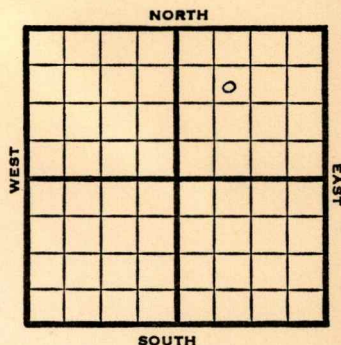

1950

Elev 1645' REPORT

3/29

8" @ 229'

WOC

4/19

TD 3765'

8" @ 229'

Heeb 2646'

Br Lime 2800'

Lans 2835'

DST 3149-62

opn 1 hr

Rec 10' mud

DST 3162-91

opn 1 hr

Rec 600' muddy salty wtr.

Cong 3335'

Miss 3357'

DST 3354-75

opn 40 mins.

Rec 12' mud

Kinderhook 3383'

Viola 3643'

Simp 3685'

Arb. 3739'

DST 3741-50 opn 25 mins.

Rec 2820' salty sulphur wtr.

BHP 1338#

TD 3765'

D&A

Aband.

ABANDONED

Map No. _____ Sec. 18 Twp. 20 R. 6W


Well No. 1 Burke

Atlantic Company

Lohman & Johnson Contractor

SE NW NE

SECTION PLAT

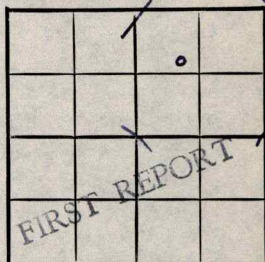

990 Ft. from N. Line

_____ Ft. from S. Line

_____ Ft. from E. Line

990 Ft. from W. Line

Rice County

Location _____

Rig up _____

Drilling and Remarks:

8" @ 229 WOC

RECORD

Cased _____ in., _____ ft.

Sand _____

Gas _____

Oil _____

Total Depth _____

PRODUCTION

1st 24 hrs. Nat. _____

1st 24 hrs. after shot _____

Gas _____ Cu. Ft.

Dry Hole _____

Abandoned _____

Date

MAR 29 1950 19

J. E. TYRA

Scout

Kansas

Wildcat

Map No. _____ Sec. 18 Twp. 20 R. 6WWell No. 1 BurkeAtlantic Company

Contractor

SE NW NE

E. 1645

SECTION PLAT

990 Ft. from N. Line

_____ Ft. from S. Line

_____ Ft. from E. Line

990 Ft. from W. Line

Rice County

Location _____

Rig up _____

Drilling and Remarks:

8" C 229Neelb. 2646Br. line 2800Lans. 2835DST 3149-62open 1 hr.Rec. 10 mudDST 3162-91open 1 hr.

Date

APR 19 1950

RECORD

Cased _____ in., _____ ft.

Sand _____

Gas _____

Oil _____

Total Depth 3765

PRODUCTION

1st 24 hrs. Nat. _____

1st 24 hrs. after shot _____

Gas _____ Cu. Ft.

Dry Hole _____

Abandoned _____

Rec. 660' muddy salty water

J. E. TYRA

Scout

Comp. 3335
Mills 3357
DST 3354-75
Open 40 min
Rec. 12' mud
Kinderhook 3383
Viola 3643
Simp. 3685
Arb. 3739
DST 3741-50

Open 25 min.

Rec. 2820' salty sulphur water

BHP 1338[#]

T.D. 3765

D & A

APR 28 1950

Scout Cards
Land Small Map
Land Wall Map
Tracings
France Map
Pierce Map
Misc.