
FORM 51-5M-6-29-PETROL McPherson

Map No. KANSAS Sec. 18 Twp. 20 R. 1 W

Well No. 1 T-Bosky Farm

Helmrick & Payne Inc Company

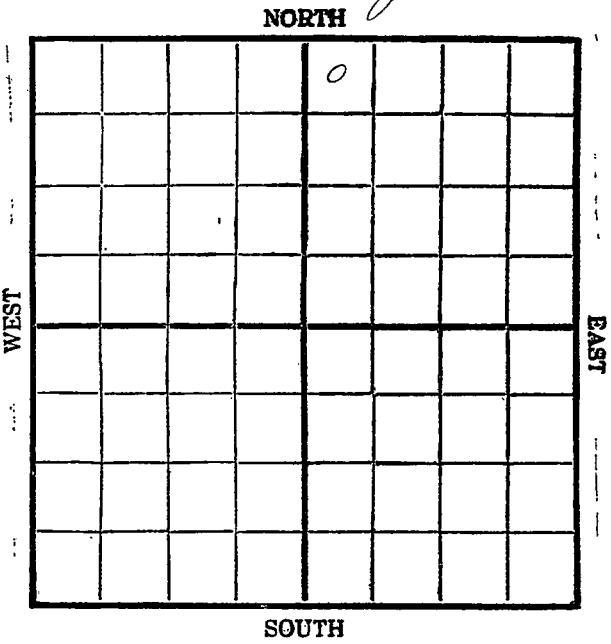

Location _____

Drilling Remarks

Rig Up _____

Drilling Remarks

RECORD

Cased _____ in. _____ ft.

Sand _____

Gas _____

Oil _____

Total Depth _____

PRODUCTION

1st 24 hrs. Nat. _____

1st 24 hrs. after shot _____

Gas _____ cu. ft.

Dry Hole _____

Abandoned _____

McPherson

Form 252A—5M—11-29—38055

Map No. KANSAS Sec. 18 Twp. 20 R. 1W

Well No. 1 - Boskin Farm


Hellmerich & Payne Company

330 Ft. from N. Line

Ft. from S. Line

Ft. from E. Line

330 Ft. from W. Line

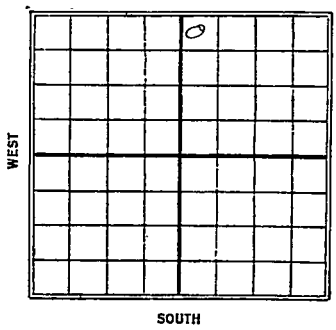

1930

Date	REPORT
10/29	Rdy.
11/5	Rig up.
11/12	"
11/19	Spud
11/25	Drlg. 550'
12/3	" 1375'
12/10	" 1800'
12/17	Set 10"-2275'
12/23	Drlg 2324
12/30	" 2550
1931	
1/7	Vic 8"-2937
1/14	8"-2957
	Drlg 2952'
1/21	Top Chat 2959
	Show gas 2965
	" P.B.P.
1/28	HFW at 3000
	Drlg 3150'
2/4	Lake Mis. 3200
	Drlg 3287
2/11	" 3410'

2/18- Drlg 3485' HFW
2/25- SD 3485' HFW
3/4
3/11- T.D. 3485
dry & abandon

Form 26 ~~IMBlss 9-28~~ 11-6 Rev

Map No. KANSAS Sec. 18 Twp. 20 R. 1 W


43

Well No. 1 Bosker

Helmerich & Payne Drlg Company

Contractor

SECTION PLAT

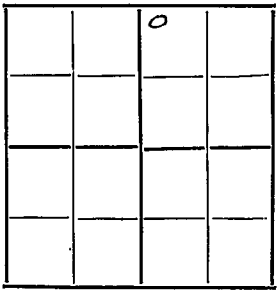

330 Ft. from N. Line

Ft. from S. Line

Ft. from E. Line

330 Ft. from W. Line

FIRST REPORTS

Location

Rig up

Drilling and Remarks:

Building rig

RECORD

Cased in., ft.

Sand

Gas

Oil

Total Depth

PRODUCTION

1st 24 hrs. Nat.

1st 24 hrs. after shot.

Gas Cu. Ft.

Dry Hole

Abandoned

Date

OCT 29 1930

S. J. LEWIS Scout

Form 2B—1M Blks.—9-26

W. Preston

Map No. KANSAS Sec. 18 Twp. 28 R. 1 W


43

Well No. 1 Barker

Helmerich & Payne, Inc. Company

Contractor

SECTION PLAT

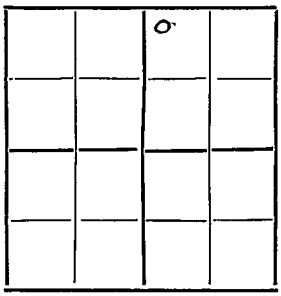

330 Ft. from N. Line

Ft. from S. Line

Ft. from E. Line

330 Ft. from W. Line

ABANDONED

Location

Rig up

Drilling and Remarks:

RECORD

Cased in., ft.

Sand

Gas

Oil

Total Depth 8485

PRODUCTION

1st 24 hrs. Nat.

1st 24 hrs. after shot

Gas Cu. Ft.

Dry Hole

Abandoned

Date

MAR 1 1 1931 1932 - S. J. LEWIS Scout